


RS = 2100 X2400

SHOPPING -01				
S.NO.	ATTRIBUTES	SANCTIONED F.A.R.(SQMT.)	ACHIEVED F.A.R.(SQMT)	ADDED AREA WITHOUT SANCTION
1	GROUND FLOOR	212.948	210.309	0.000
	TOTAL	212.948	210.309	0.000

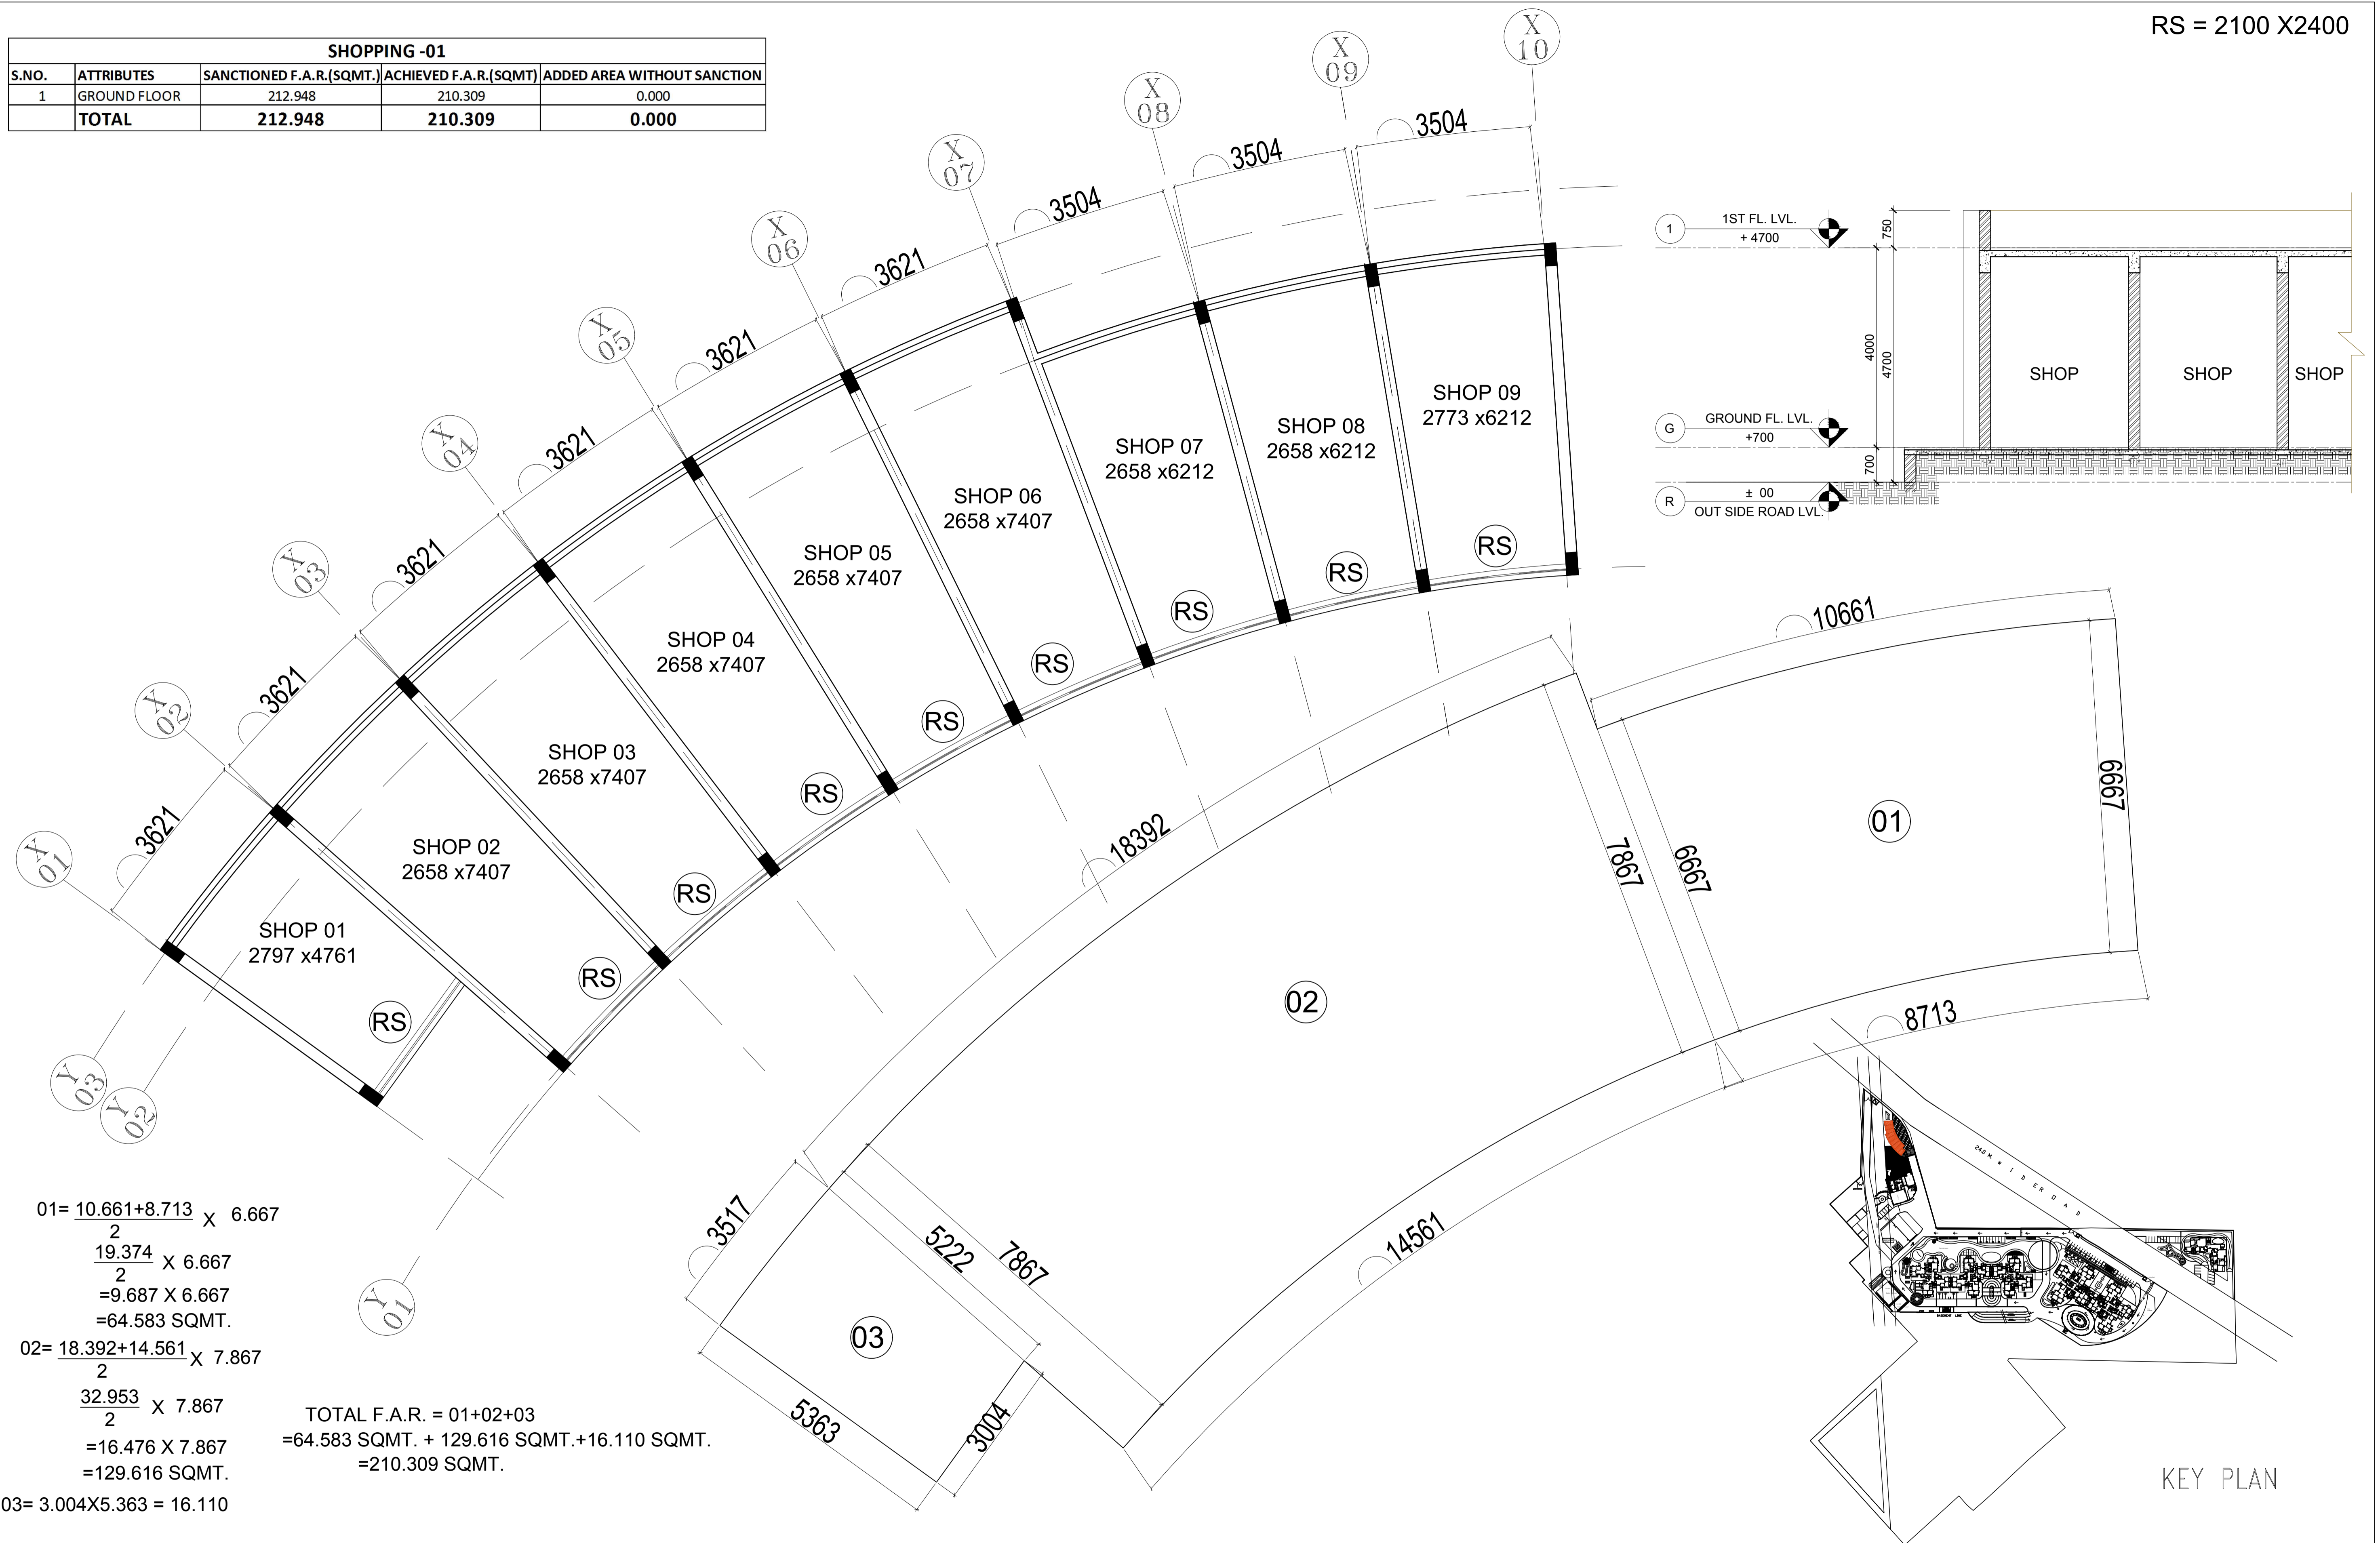

01= $\frac{10.661+8.713}{2} \times 6.667$
 $\frac{19.374}{2} \times 6.667$
 $=9.687 \times 6.667$
 $=64.583$ SQMT.

02= $\frac{18.392+14.561}{2} \times 7.867$
 $\frac{32.953}{2} \times 7.867$
 $=16.476 \times 7.867$
 $=129.616$ SQMT.

03= $3.004 \times 5.363 = 16.110$

TOTAL F.A.R. = 01+02+03
 $=64.583$ SQMT. + 129.616 SQMT.+ 16.110 SQMT.
 $=210.309$ SQMT.

KEY PLAN

PROJECT:- PROPOSED PROPOSED GROUP HOUSING AT PLOT NO.- THE ESPHERA' AT SECTOR-37 C, GURGAON FOR -----	ARCHITECT'S SIGNATURE	CLIENT'S SIGNATURE	LOCAL AUTHORITY SUBMISSION	SUBMISSION DRAWING	 DESIGN FORUM OF ARCHITECTS www.dfa.in C-10, SECTOR - 3, NOIDA - 201301 (NCR DELHI) INDIA TEL : +91 120 460 1000 FAX : +91 120 460 1000 dfaconsultants@gmail.com	DRG. NO. 101
			SCALE : 1:100	COMMERCIAL BLOCK GROUND FLOOR PLAN		REV.
			DATE : ----			