


DOOR SCHEDULE				
S.NO.	TYPE	SIZE	CELL LEVEL	LINTEL LEVEL
1	D1	1200 X 2100	00	2100
2	D2	1200 X 2100	00	2100
3	D3	900 X 2100	00	2100
4	D4	750 X 2100	00	2100
5	D4'	750 X 2400	00	2400
6	DW1	2400 X 2400 / 2100	00/300	2400
7	DW2	1800 X 2400 / 2100	00/300	2400
8	DW3	1600 X 2400 / 2100	00/300	2400
9	DW4	1500 X 2400 / 1350	00/1050	2400
10	DW5	1300 X 2400 / 2100	00/300	2400
11	FD	1200 X 2100	00	2100


WINDOW SCHEDULE			
S.NO.	TYPE	SIZE	AREA
1	W1	1600 X 2100	300
2	W2	2400 X as' staircase detail	
3	W2'	2400 X as' staircase detail (opening with louvers)	
4	W3	1200 X 2100	300
5	W4	1000 X 1350	1050
6	W5	700 X 2100	300
7	W6	480 X 2100	300
8	V	600 X 1200	1200

ACCESS DOOR			
S.NO.	TYPE	SIZE	AREA
1	AD1	900 X 1800	300
2	AD2	900 X 1800	300

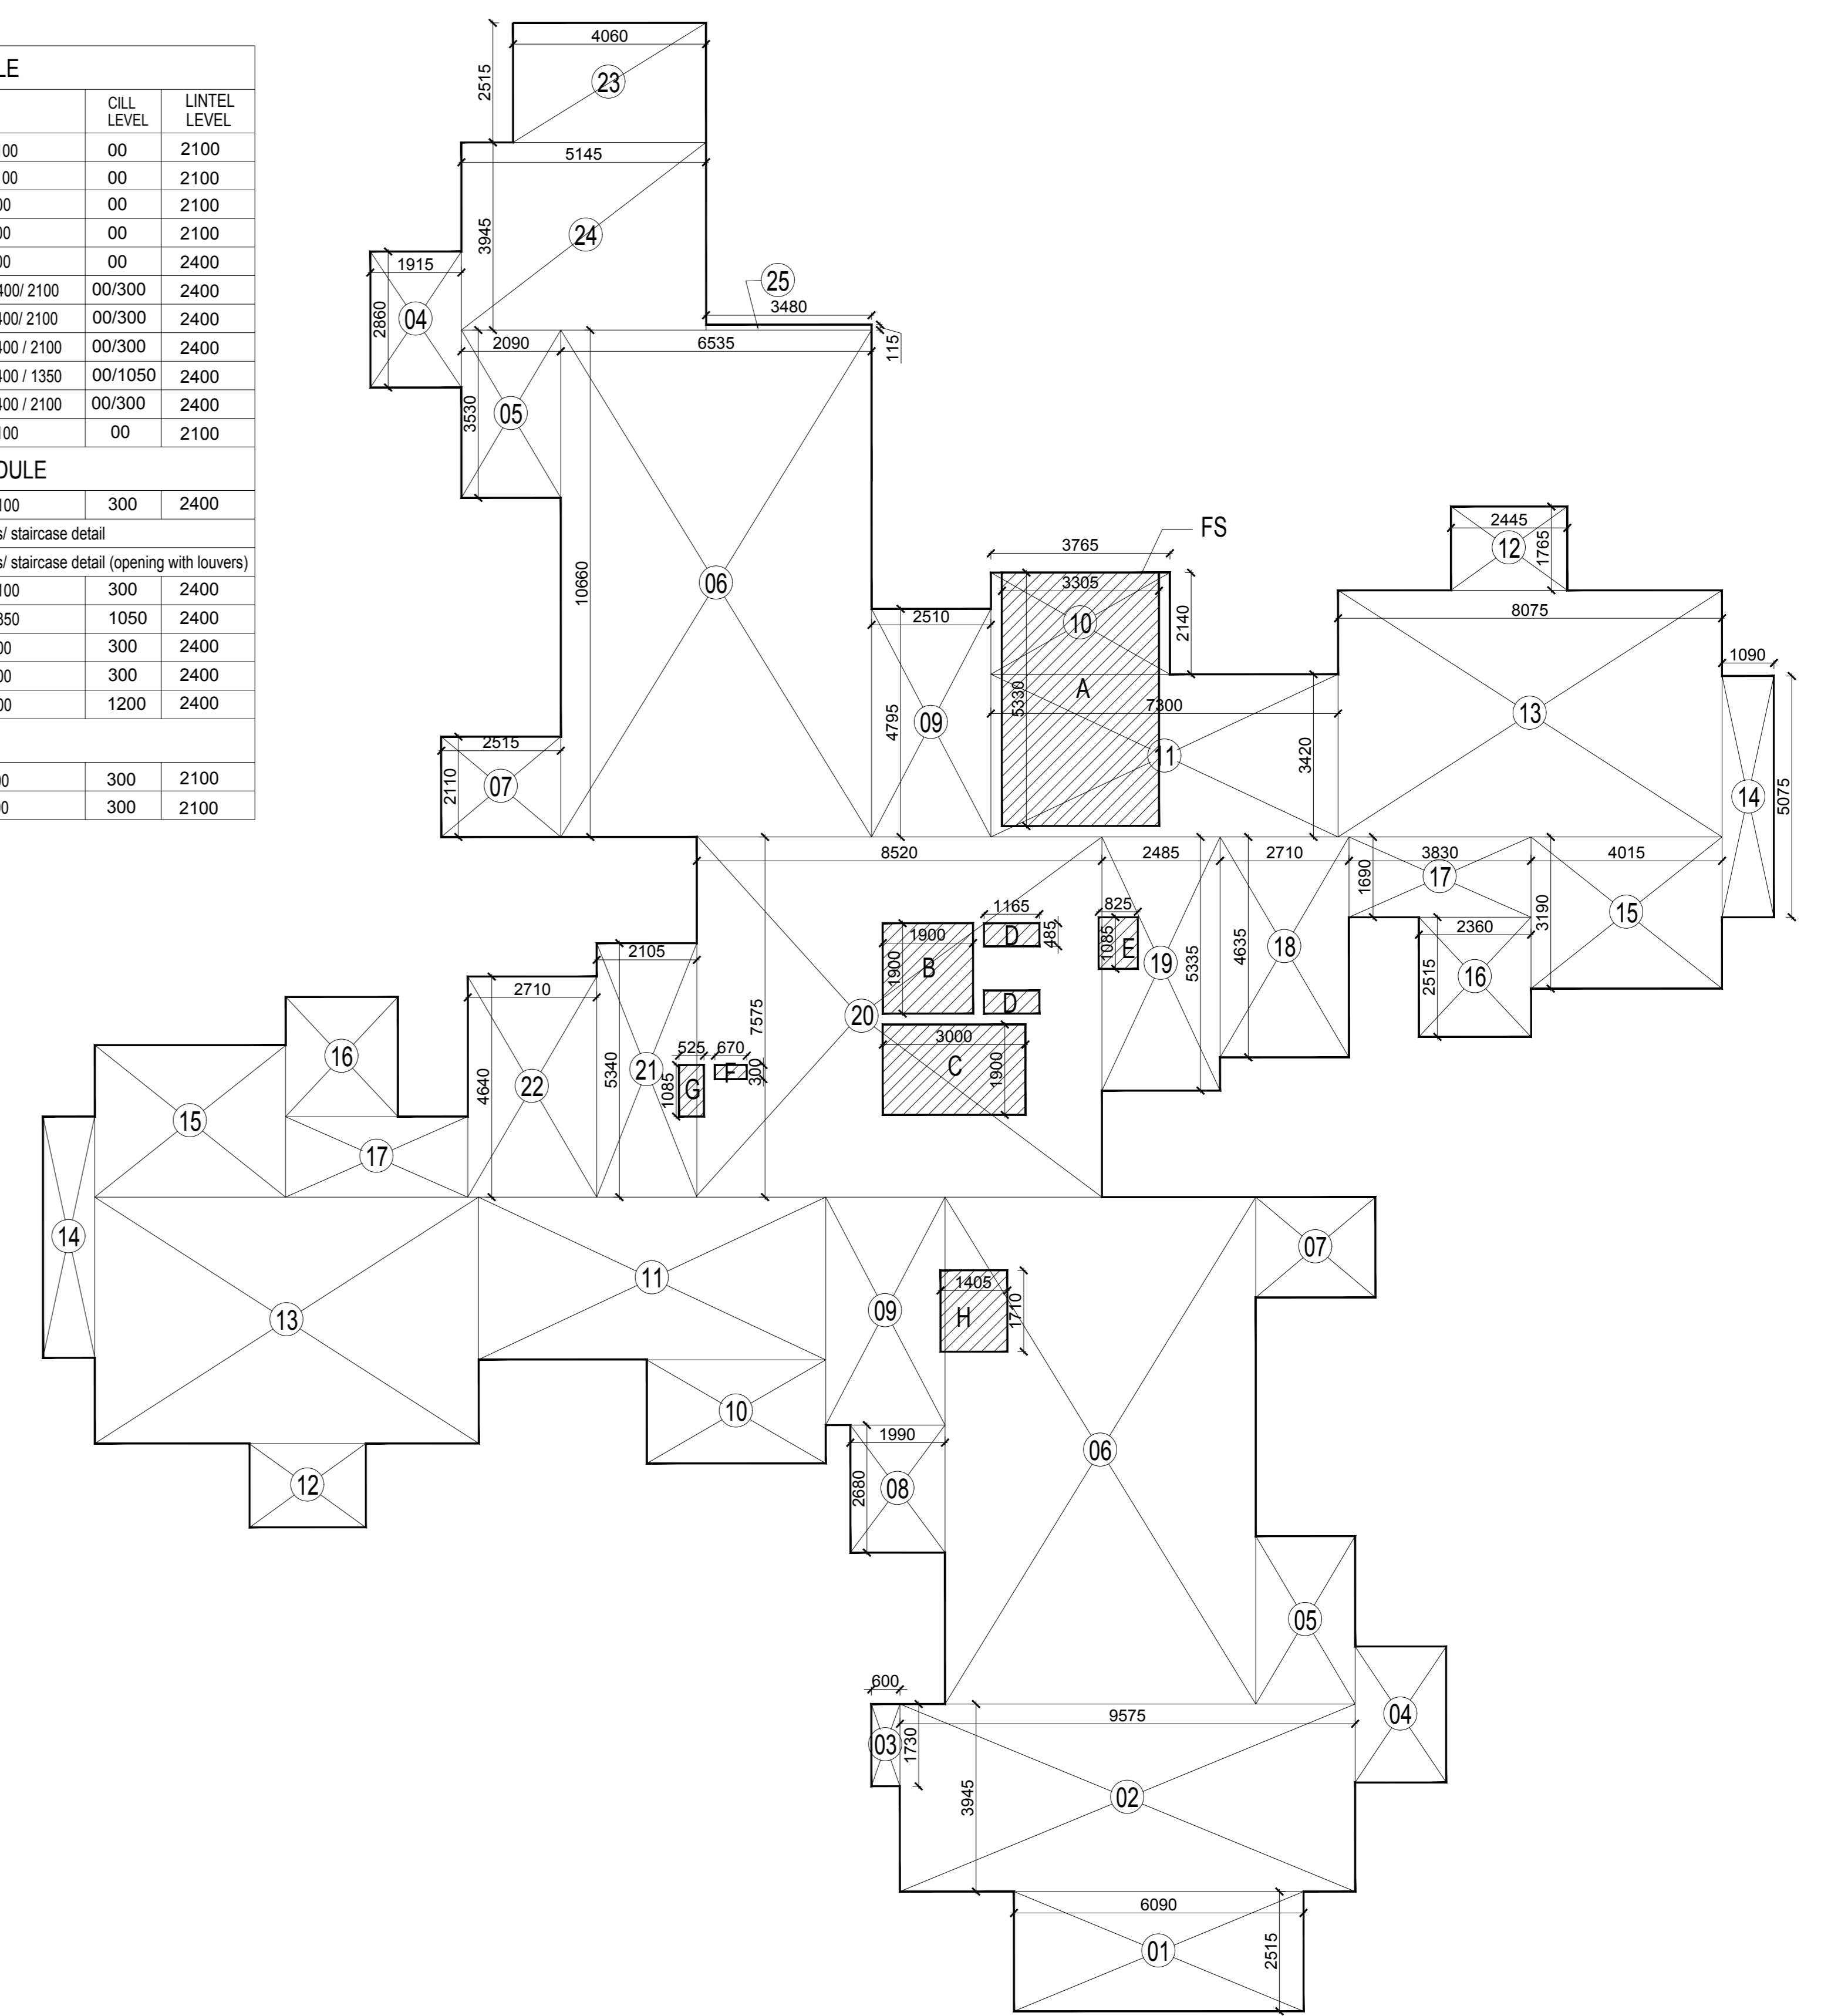

19TH. FLOOR UPPER PENTHOUSE

TOWER A- PANT HOUSE 19TH. FLOOR F.A.R. COVERED AREA CALCULATIONS					
TOTAL AREA	LENGTH	WIDTH	AREA	NO.	TOTAL
01	6.09	2.515	0	15.316	1
02	9.575	3.945	0	37.773	1
03	0.16	1.73	0	1.008	1
04	1.915	2.86	0	5.477	2
05	2.09	8.51	0	17.78	14.955
06	6.535	10.66	0	69.663	2
07	2.515	2.11	0	5.307	2
08	1.89	2.66	0	5.333	1
09	2.51	4.795	0	12.035	2
10	3.765	2.14	0	8.057	2
11	7.3	3.47	0	24.966	2
12	2.445	1.765	0	4.315	2
13	8.075	5.185	0	41.869	2
14	1.09	5.075	0	5.522	2
15	4.015	3.19	0	12.808	2
16	2.36	2.515	0	5.935	2
17	3.88	1.69	0	6.473	2
18	2.71	4.835	0	13.101	1
19	2.485	5.335	0	13.257	1
20	8.51	7.975	0	67.539	1
21	2.305	5.34	0	11.241	1
22	2.71	4.64	0	12.574	1
23	4.06	2.515	0	10.211	1
24	5.45	3.945	0	20.297	1
25	3.48	0.115	0	0.400	1
TOTAL (A)					624.171
LIFT WELL					
B	1.9	1.9	0	3.610	1
C	1.9	3	0	5.700	1
TOTAL (B)					9.310
FIRE STAIRCASE (free of fall)					
A	5.33	3.925	0	20.918	1
TOTAL (C)					17.616
CUT-OUT					
D	1.885	0.485	0	0.965	2
E	1.085	0.825	0	0.895	1
F	0.67	0.3	0	0.201	1
G	0.525	1.085	0	0.570	1
H	3.425	1.73	0	2.403	1
TOTAL (D)					5.198
TOTAL FAR AREA = A+(B+C+D)					592.007

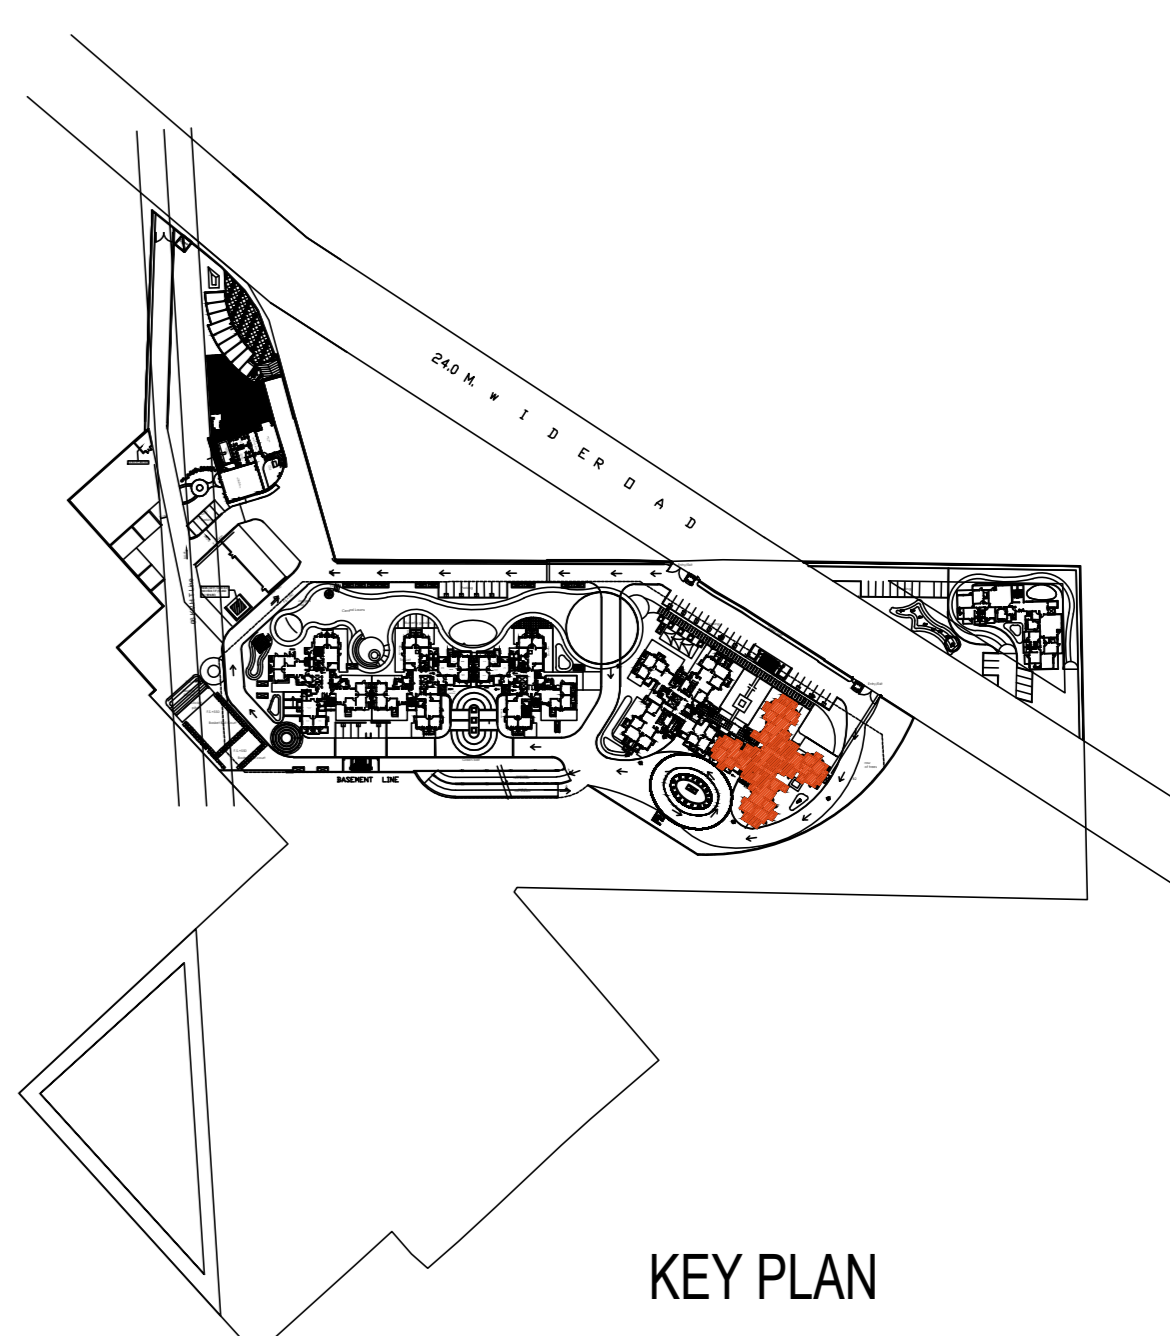

KEY PLAN

PROJECT:-	ARCHITECT'S SIGNATURE	CLIENT'S SIGNATURE	<p>DESIGN FORUM ARCHITECTS www.dfa.in C-10, SECTOR-3, NOIDA-201301 (NCR DELHI) INDIA TEL: +91 120 460 1000 FAX: +91 120 460 1000 dfaconsultants@gmail.com</p>	DRG. NO.
AS BUILT DRAWING OF GROUP HOUSING AT PLOT NO.- THE ESFERA' AT SECTOR-37 C, GURGAON FOR				104
SCALE : 1:100				REV.
DATE : ---				
TOWER (A) PENTHOUSE UPPER FLOOR 19TH. FLOOR PLAN				