

GROUND FLOOR PLAN


DOOR SCHEDULE				
S.NO.	TYPE	SIZE	CLL LEVEL	LINTEL LEVEL
1	D1	1200 X 2100	00	2100
2	D2	1200 X 2100	00	2100
3	D3	900 X 2100	00	2100
4	D4	750 X 2100	00	2100
5	D4'	750 X 2400	00	2400
6	DW1	2400 X 2400/2100	00/300	2400
7	DW2	1800 X 2400/2100	00/300	2400
8	DW3	1600 X 2400/2100	00/300	2400
9	DW4	1500 X 2400/1350	00/1050	2400
10	DW5	1300 X 2400/2100	00/300	2400
11	FD	1200 X 2100	00	2100

WINDOW SCHEDULE				
S	W	SIZE	CLL LEVEL	LINTEL LEVEL
1	W1	1600 X 2100	300	2400
2	W2	2400 X as/ staircase detail		
3	W2'	2400 X as/ staircase detail (opening with louvers)		
4	W3	1200 X 2100	300	2400
5	W4	1000 X 1350	1050	2400
6	W5	700 X 2100	300	2400
7	W6	480 X 2100	300	2400
8	W7	1300 X 2100	300	2400
9	V	600 X 1200	1200	2400


  

ACCESS DOOR			
S	AD	SIZE	LEVEL
1	AD1	900 X 1800	300 2100
2	AD2	900 X 1800	300 2100

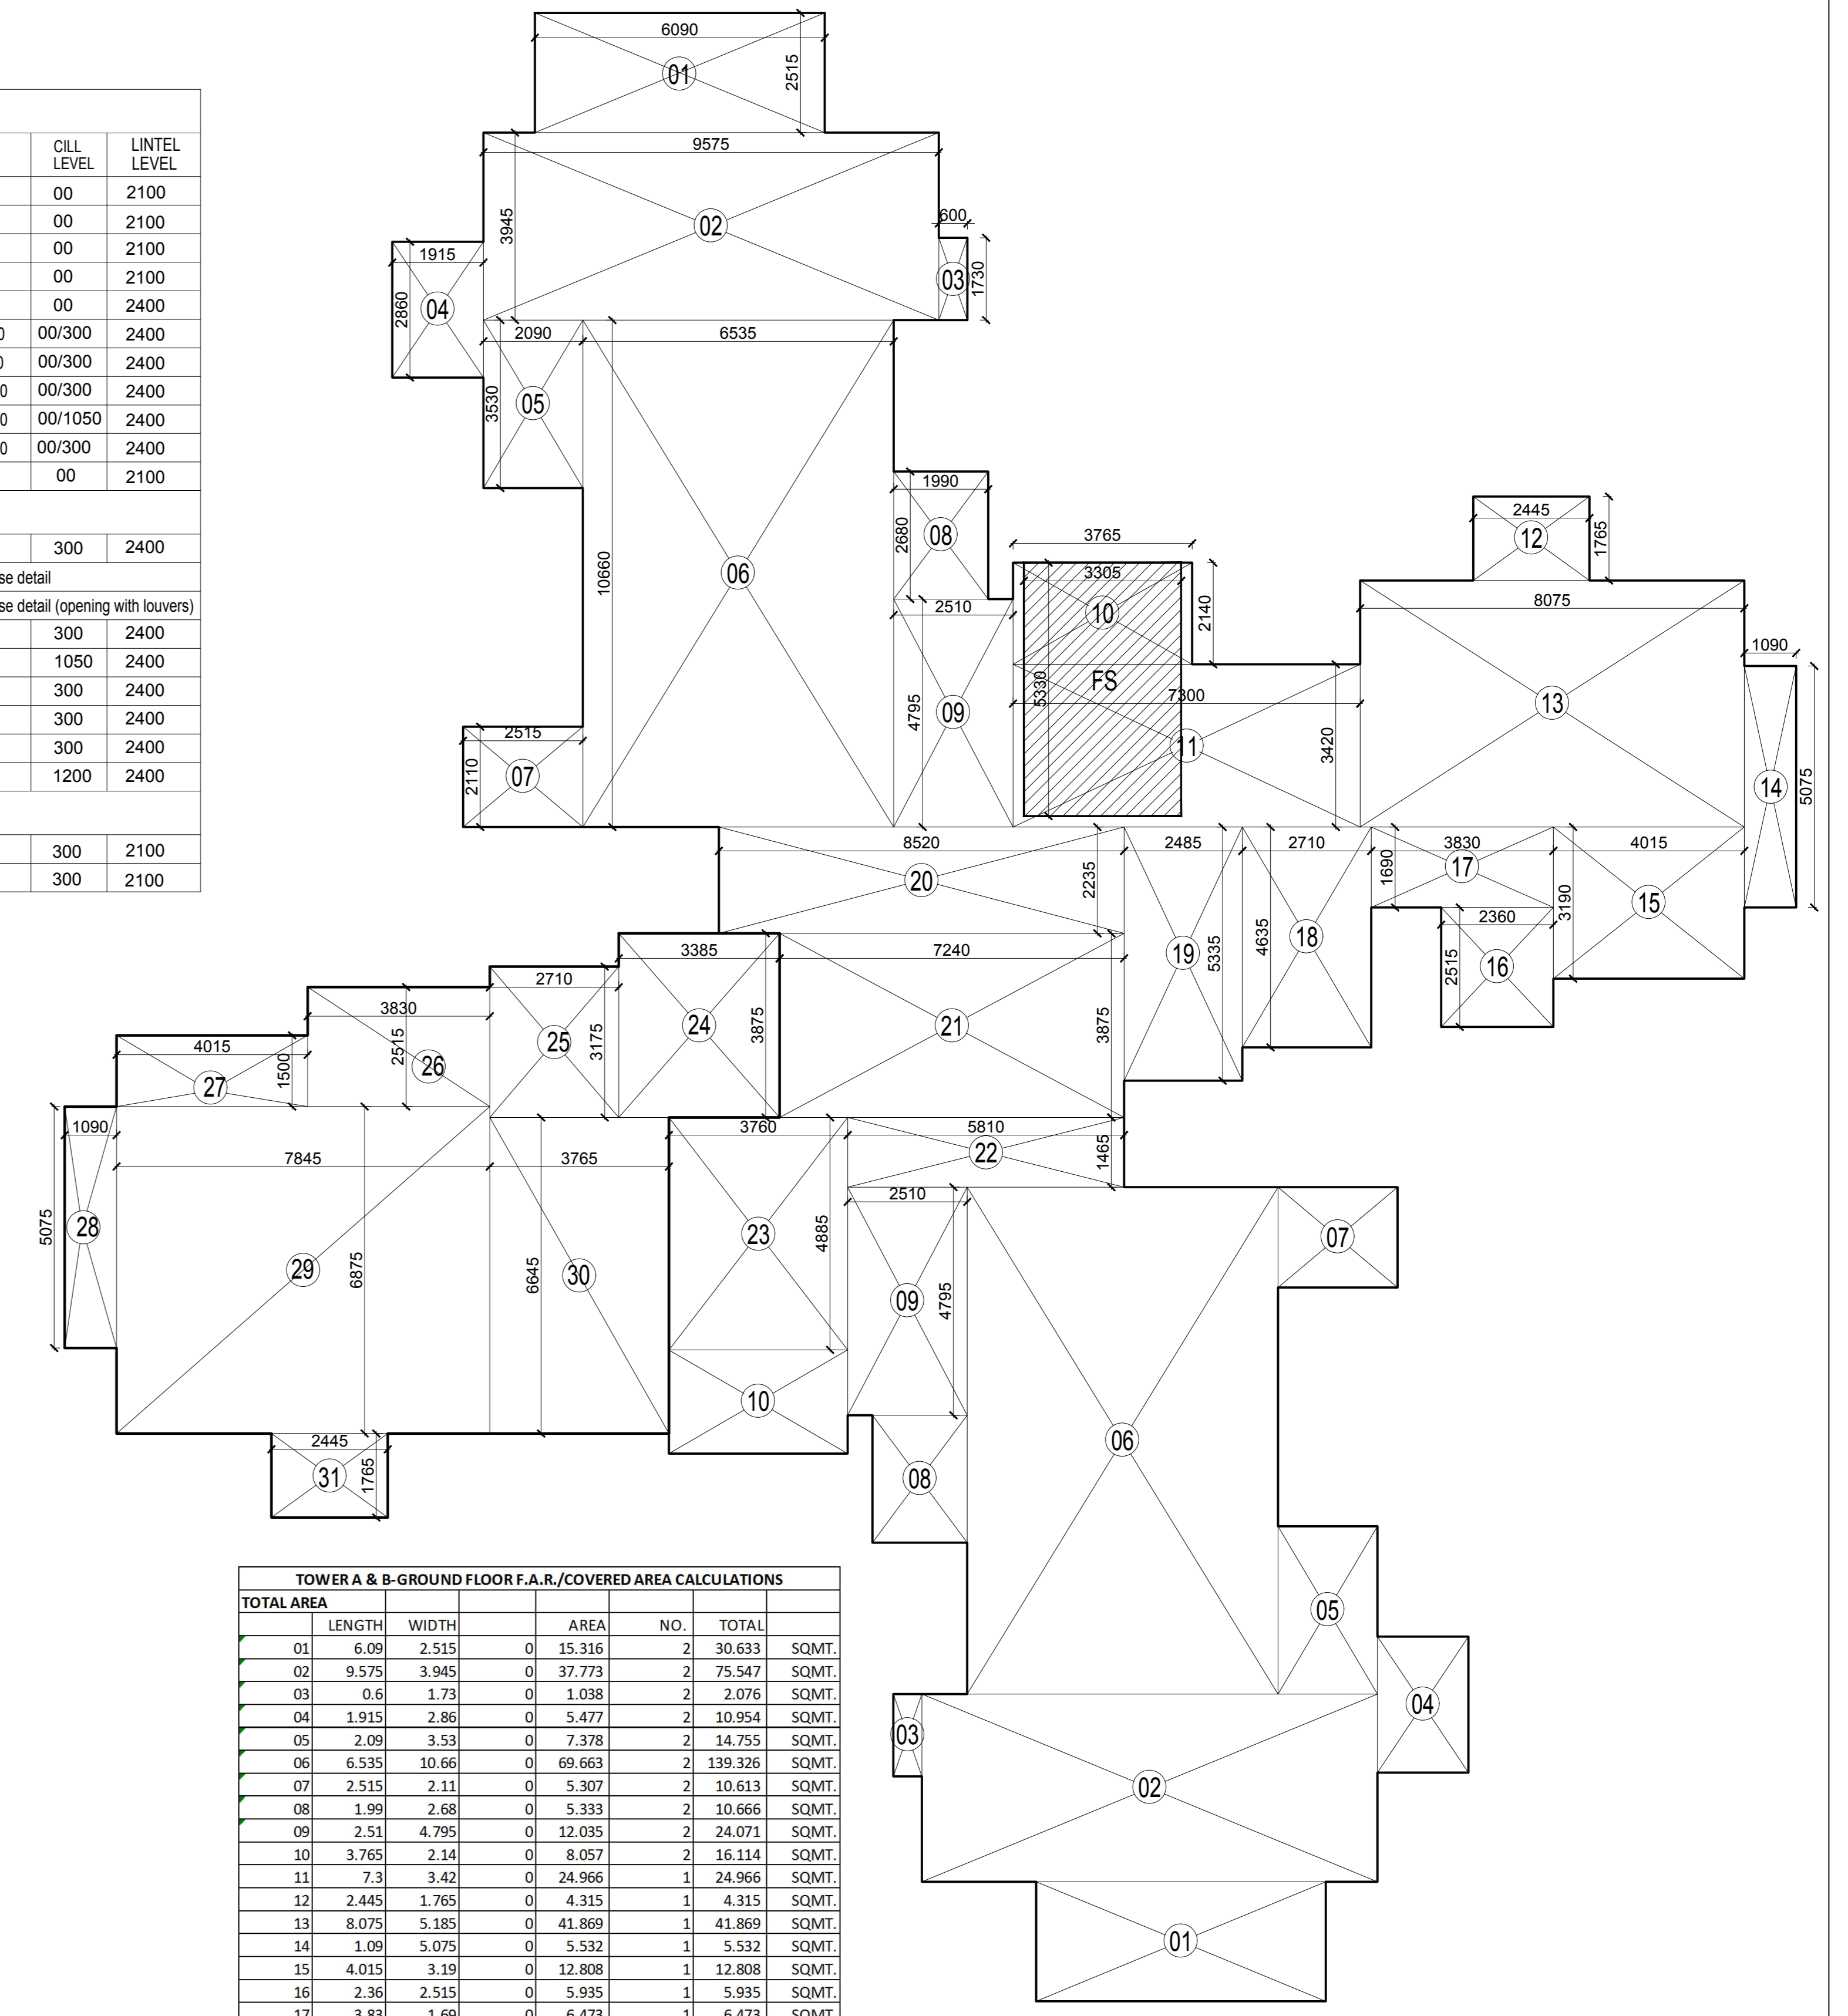

GROUND FLOOR DIAGRAM

TOWER A & B-GROUND FLOOR F.A.R./COVERED AREA CALCULATIONS						
TOTAL AREA	LENGTH	WIDTH	AREA	NO.	TOTAL	
01	6.09	2.515	0	15.316	2	30.633 SQMT.
02	9.575	3.945	0	37.773	2	75.547 SQMT.
03	0.6	1.73	0	1.038	2	2.076 SQMT.
04	1.915	2.26	0	4.377	2	8.754 SQMT.
05	2.09	3.53	0	7.378	2	14.755 SQMT.
06	6.535	10.66	0	69.663	2	139.326 SQMT.
07	2.515	2.11	0	5.307	2	10.613 SQMT.
08	1.99	2.68	0	5.333	2	10.666 SQMT.
09	2.51	4.795	0	12.035	2	24.071 SQMT.
10	3.765	2.14	0	8.057	2	16.114 SQMT.
11	7.3	3.42	0	24.966	1	24.966 SQMT.
12	2.445	1.765	0	4.315	1	4.315 SQMT.
13	8.075	5.185	0	41.869	1	41.869 SQMT.
14	1.09	5.075	0	5.532	1	5.532 SQMT.
15	4.015	3.19	0	12.808	1	12.808 SQMT.
16	2.36	2.515	0	5.935	1	5.935 SQMT.
17	3.83	1.69	0	6.473	1	6.473 SQMT.
18	2.71	4.635	0	12.561	1	12.561 SQMT.
19	2.485	5.335	0	13.257	1	13.257 SQMT.
20	8.52	2.235	0	19.042	1	19.042 SQMT.
21	7.24	3.875	0	28.055	1	28.055 SQMT.
22	5.81	1.465	0	8.512	1	8.512 SQMT.
23	3.76	4.885	0	18.368	1	18.368 SQMT.
24	3.385	3.875	0	13.117	1	13.117 SQMT.
25	2.71	3.175	0	8.604	1	8.604 SQMT.
26	3.83	2.515	0	9.632	1	9.632 SQMT.
27	4.015	1.5	0	6.023	1	6.023 SQMT.
28	1.09	5.075	0	5.532	1	5.532 SQMT.
29	7.845	6.875	0	53.934	1	53.934 SQMT.
30	3.765	6.645	0	25.018	1	25.018 SQMT.
31	2.445	1.765	0	4.315	1	4.315 SQMT.
				<b>TOTAL (A)</b>	<b>662.624</b>	<b>SQMT.</b>
				<b>TOTAL (B)</b>	<b>17.616</b>	<b>SQMT.</b>
				<b>TOTAL FAR AREA - A+B</b>	<b>645.009</b>	<b>SQMT.</b>

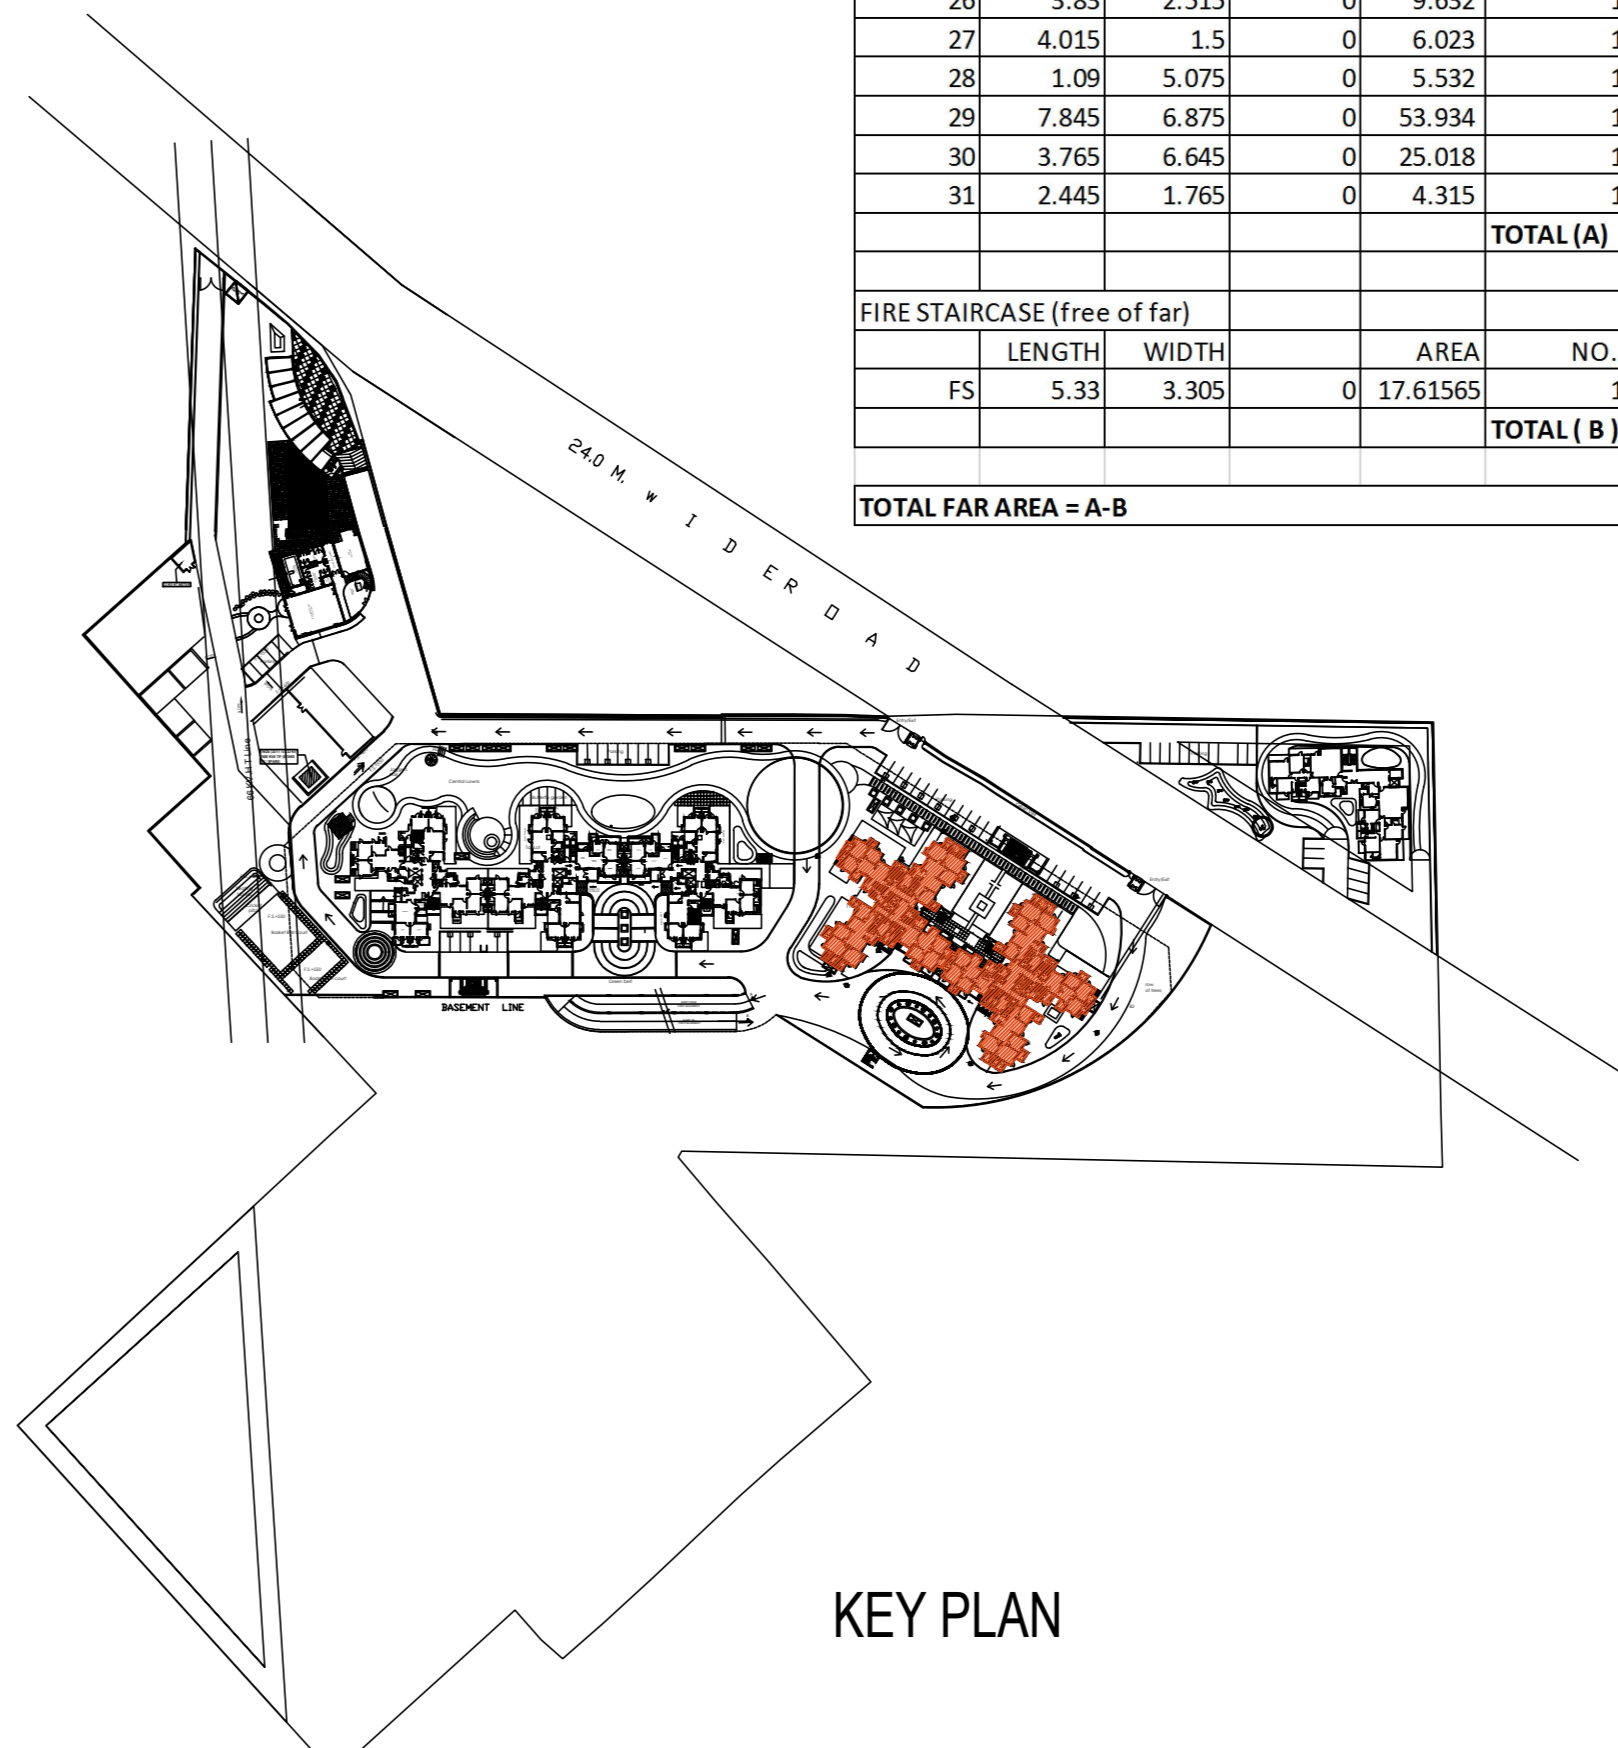

KEY PLAN

TOWER A				
S.NO.	ATTRIBUTES	SANCTIONED F.A.R.(SQMT.)	ACHIEVED F.A.R.(SQMT.)	ADDED AREA WITHOUT SANCTION
1	GROUND FLOOR	522.722	645.009	122.287
2	1ST.FLOOR	632.084	620.600	0.000
3	2ND.FLOOR	632.084	620.600	0.000
4	3RD.FLOOR	632.084	620.600	0.000
5	4TH.FLOOR	632.084	620.600	0.000
6	5TH.FLOOR	632.084	620.600	0.000
7	6TH.FLOOR	632.084	620.600	0.000
8	7TH.FLOOR	632.084	620.600	0.000
9	8TH.FLOOR	632.084	620.600	0.000
10	9TH.FLOOR	632.084	620.600	0.000
11	10TH.FLOOR	632.084	620.600	0.000
12	11TH.FLOOR	632.084	620.600	0.000
13	12TH.FLOOR	632.084	620.600	0.000
14	13TH.FLOOR	632.084	620.600	0.000
15	14TH.FLOOR	632.084	620.600	0.000
16	15TH.FLOOR	632.084	620.600	0.000
17	16TH.FLOOR	632.084	620.600	0.000
18	17TH.FLOOR	632.084	620.600	0.000
19	18TH.PENTHOUSE	632.084	620.600	0.000
20	TERRACE	632.084	592.047	0.000
<b>TOTAL</b>		<b>12532.318</b>	<b>12407.857</b>	<b>122.287</b>

TOWER B				
S.NO.	ATTRIBUTES	SANCTIONED F.A.R.(SQMT.)	ACHIEVED F.A.R.(SQMT.)	ADDED AREA WITHOUT SANCTION
1	GROUND FLOOR	522.722	645.009	122.287
2	1ST.FLOOR	632.084	620.600	0.000
3	2ND.FLOOR	632.084	620.600	0.000
4	3RD.FLOOR	632.084	620.600	0.000
5	4TH.FLOOR	632.084	620.600	0.000
6	5TH.FLOOR	632.084	620.600	0.000
7	6TH.FLOOR	632.084	620.600	0.000
8	7TH.FLOOR	632.084	620.600	0.000
9	8TH.FLOOR	632.084	620.600	0.000
10	9TH.FLOOR	632.084	620.600	0.000
11	10TH.FLOOR	632.084	620.600	0.000
12	11TH.FLOOR	632.084	620.600	0.000
13	12TH.FLOOR	632.084	620.600	0.000
14	13TH.FLOOR	632.084	620.600	0.000
15	14TH.FLOOR	632.084	620.600	0.000
16	15TH.FLOOR	632.084	620.600	0.000
17	16TH.FLOOR	632.084	620.600	0.000
18	17TH.FLOOR	632.084	620.600	0.000
19	18TH.FLOOR	632.084	620.600	0.000
20	19TH.FLOOR	632.084	620.600	0.000
21	TERRACE	632.084	592.047	0.000
<b>TOTAL</b>		<b>12532.318</b>	<b>12436.410</b>	<b>122.287</b>

PROJECT:-  
**AS BUILT DRAWING**  
 OF GROUP HOUSING AT PLOT NO.-  
 THE ESFERA' AT SECTOR-37 C, GURGAON  
 FOR -----

ARCHITECT'S SIGNATURE \_\_\_\_\_ CLIENT'S SIGNATURE \_\_\_\_\_

SCALE : 1:100

DATE : ---

TOWER (A & B)  
 GROUND FLOOR  
 PLAN



DRG. NO.

101

REV.

