

TYPICAL FLOOR PLAN

DOOR SCHEDULE				
S.NO	TYPE	SIZE	CLL LEVEL	LINTEL LEVEL
1	D1	1200 X 2100	00	2100
2	D2	1200 X 2100	00	2100
3	D3	900 X 2100	00	2100
4	D4	750 X 2100	00	2100
5	D4'	750 X 2400	00	2400
6	DW1	2400 X 2400/2100	00/300	2400
7	DW2	1800 X 2400/2100	00/300	2400
8	DW3	1600 X 2400/2100	00/300	2400
9	DW4	1500 X 2400/1350	00/1050	2400
10	DW5	1300 X 2400/2100	00/300	2400
11	FD	1200 X 2100	00	2100

WINDOW SCHEDULE			
S	W	SIZE	LEVEL
1	W1	1600 X 2100	300 2400
2	W2	2400 X as/ staircase detail	
3	W2'	2400 X as/ staircase detail (opening with louvers)	
4	W3	1200 X 2100	300 2400
5	W4	1000 X 1350	1050 2400
6	W5	700 X 2100	300 2400
7	W6	480 X 2100	300 2400
8	W7	1300 X 2100	300 2400
9	V	600 X 1200	1200 2400

ACCESS DOOR		
S	AD	LEVEL
1	AD1	900 X 1800 300 2100
2	AD2	900 X 1800 300 2100

AY 01
AY 02
AY 03
AY 04
AY 05
AY 06
AY 07
AY 08
AY 09
AY 10
AY 11
AY 12
AY 13
AY 14
AY 15
AY 16
AY 17
AY 18
AY 19
AY 20
AY 21
AY 22
AY 23
AY 24
AY 25
AY 26
AY 27
AY 28


TOWER A & B - TYPICAL FLOOR F.A.R./COVERED AREA CALCULATIONS					
TOTAL AREA	LENGTH	WIDTH	AREA	NO.	TOTAL
01	6.09	2.515	15.316	2	30.633 SQMTR.
02	9.575	3.945	37.773	2	75.547 SQMTR.
03	0.6	1.75	1.050	2	2.076 SQMTR.
04	1.915	2.86	5.477	2	10.954 SQMTR.
05	2.09	3.53	7.378	2	14.755 SQMTR.
06	6.525	10.66	69.463	2	138.926 SQMTR.
07	2.515	2.11	5.307	2	10.613 SQMTR.
08	1.99	2.48	4.933	2	9.866 SQMTR.
09	2.51	4.795	12.035	2	24.071 SQMTR.
10	3.765	2.14	8.057	2	16.114 SQMTR.
11	7.1	3.42	24.198	2	48.397 SQMTR.
12	2.44	1.76	4.283	2	8.567 SQMTR.
13	8.075	5.185	41.869	2	83.738 SQMTR.
14	1.09	5.079	5.532	2	11.064 SQMTR.
15	4.015	1.19	4.778	2	9.556 SQMTR.
16	2.36	2.515	5.935	2	11.871 SQMTR.
17	3.88	1.69	6.573	2	13.146 SQMTR.
18	2.71	4.635	12.561	1	12.561 SQMTR.
19	2.485	5.335	13.257	1	13.257 SQMTR.
20	8.52	7.975	67.939	1	67.939 SQMTR.
21	2.09	5.34	11.241	1	11.241 SQMTR.
22	2.71	4.64	12.574	1	12.574 SQMTR.
TOTAL (A)					692.724 SQMTR.

LIFT WELL					
LENGTH	WIDTH	AREA	NO.	TOTAL	
B	1.9	1.9	3.610	1	3.610 SQMTR.
C	1.9	8	15.200	1	15.200 SQMTR.
TOTAL (B)					9.810 SQMTR.


FIRE STAIRCASE (free of fair)					
LENGTH	WIDTH	AREA	NO.	TOTAL	
A	5.33	3.905	20.816	1	20.816 SQMTR.
TOTAL (C)					20.816 SQMTR.

OUT-OUT					
LENGTH	WIDTH	AREA	NO.	TOTAL	
D	1.165	0.805	0.939	1	0.939 SQMTR.
E	1.085	0.825	0.895	1	0.895 SQMTR.
F	0.67	0.5	0.335	1	0.335 SQMTR.
G	0.525	1.085	0.570	1	0.570 SQMTR.
H	1.405	1.71	2.403	1	2.403 SQMTR.
TOTAL (D)					5.138 SQMTR.

TOTAL FAR AREA = A + (B+C+D) = 820.000 SQMTR.

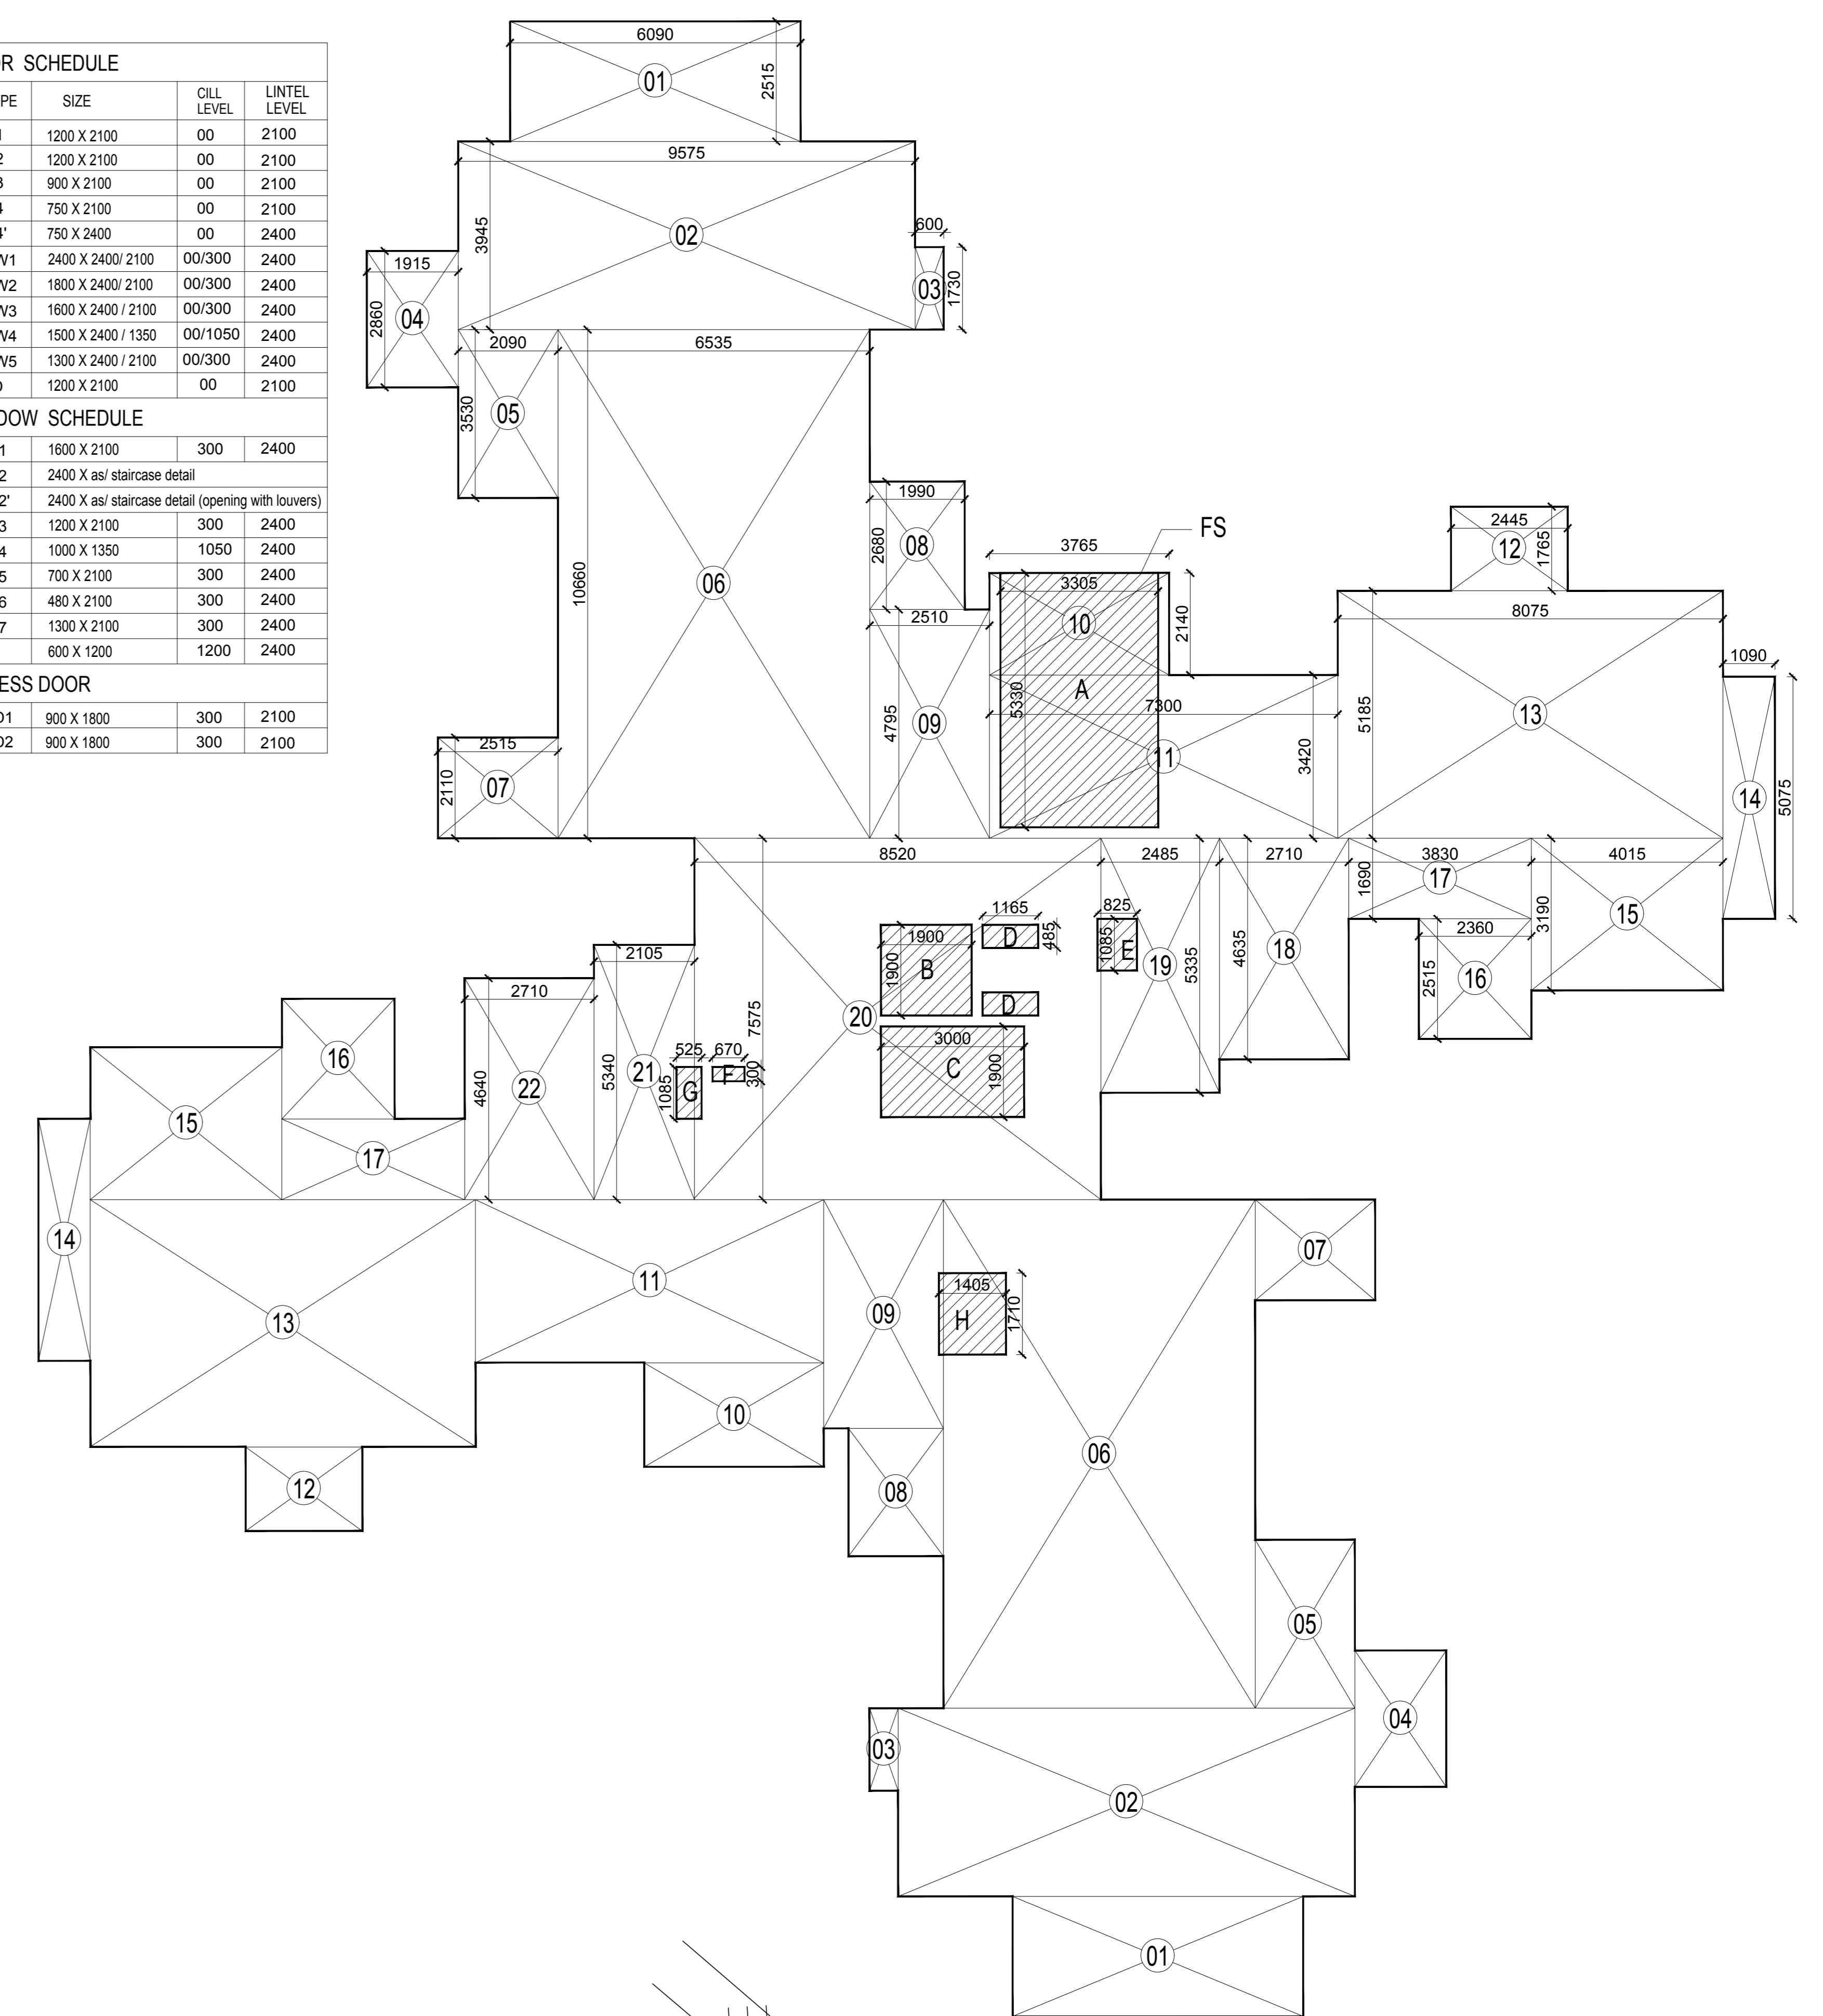

TYPICAL FLOOR DIAGRAM

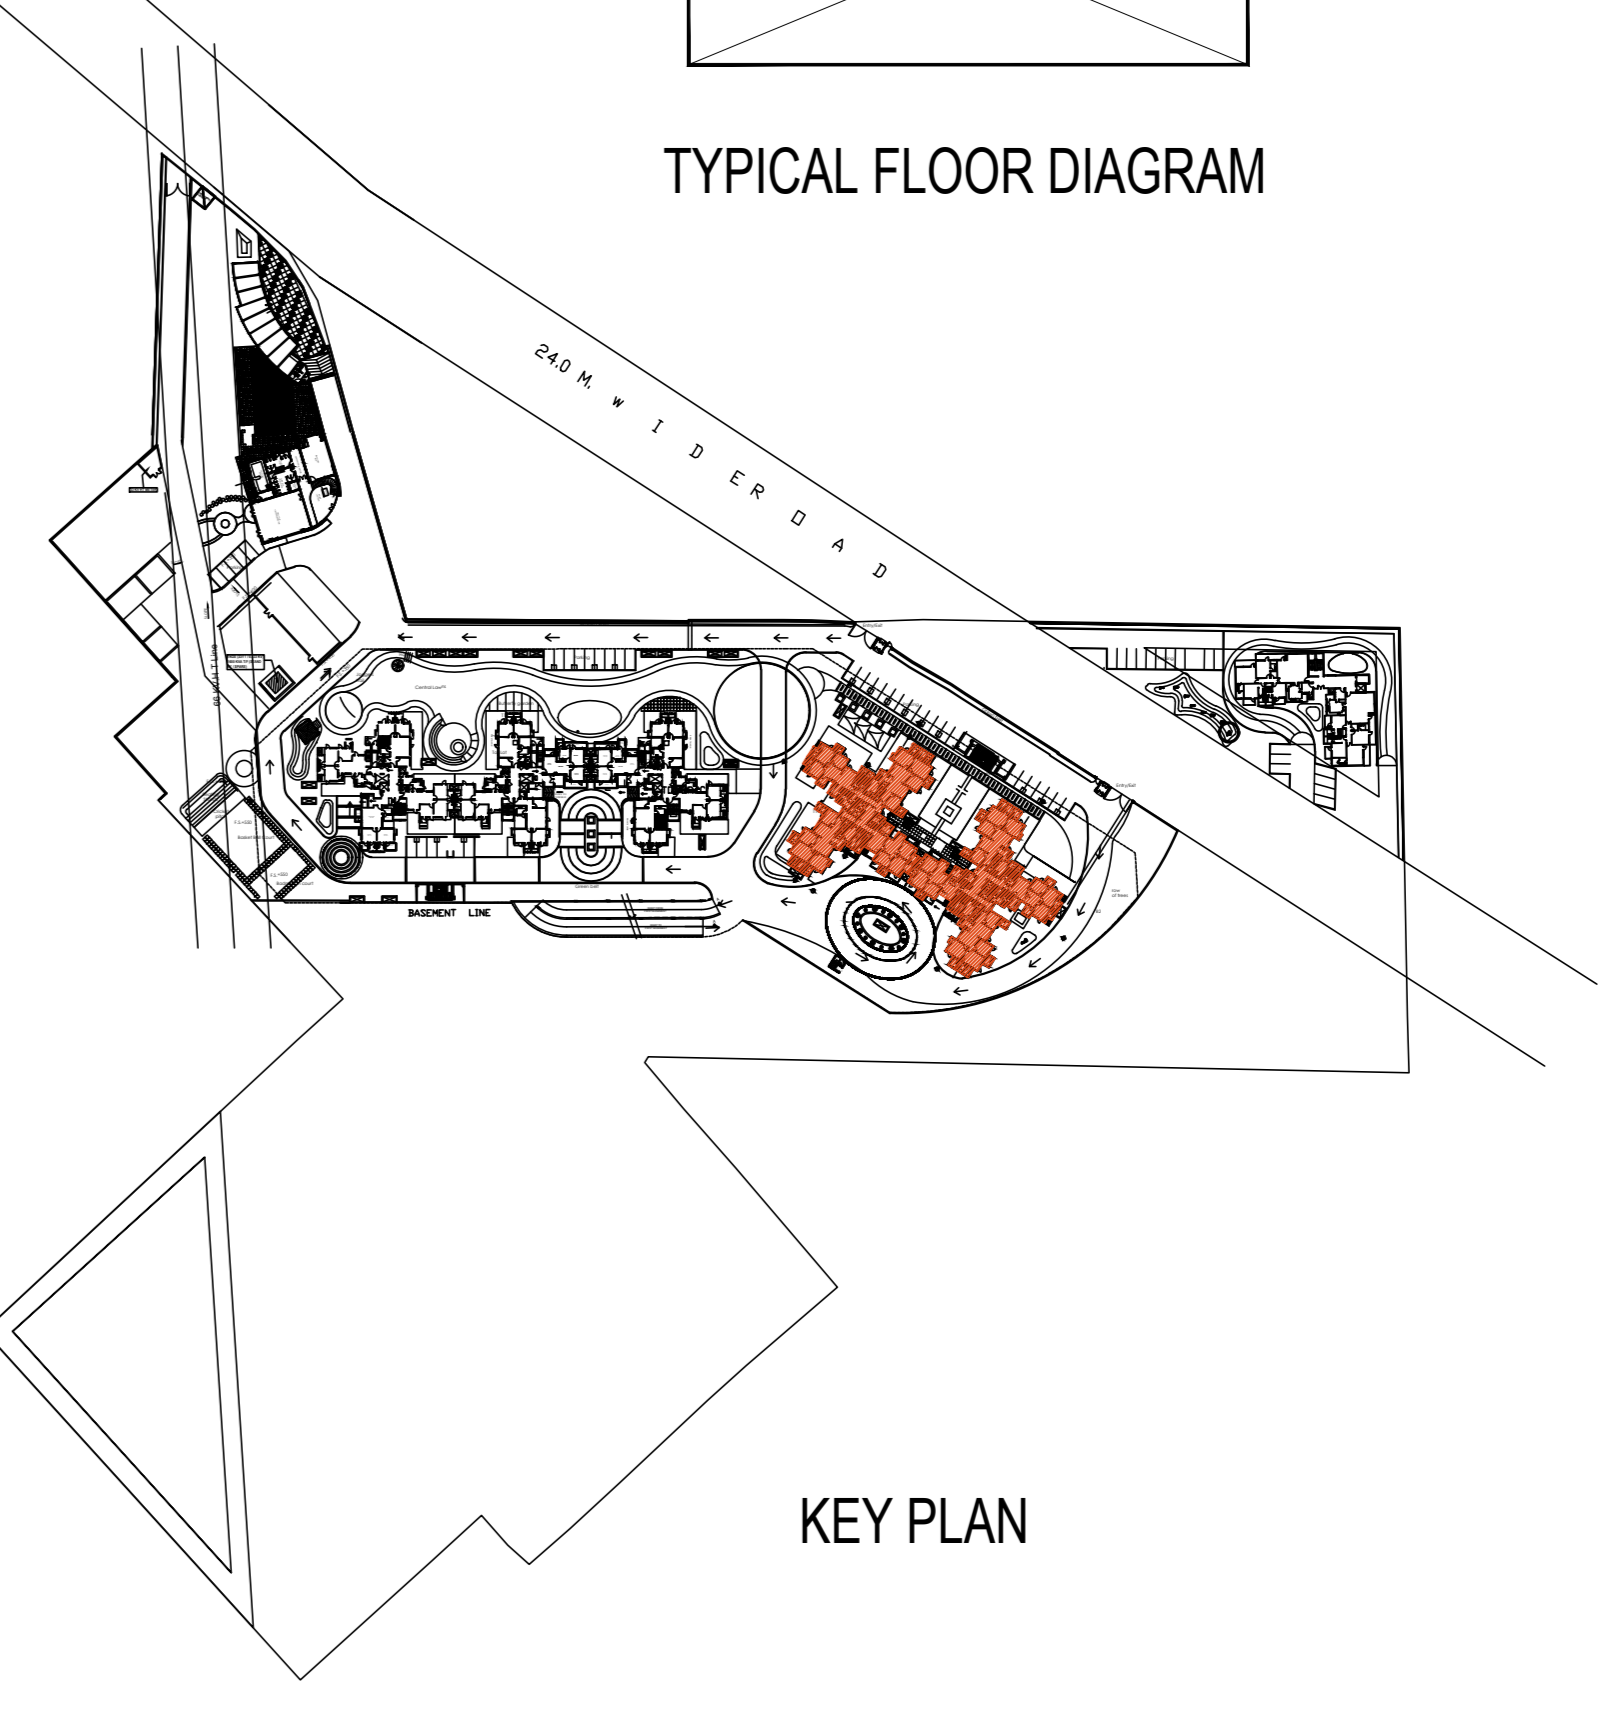

KEY PLAN

PROJECT:-

AS BUILT DRAWING
OF GROUP HOUSING AT PLOT NO.-
THE ESFERA' AT SECTOR-37 C, GURGAON
FOR -----

ARCHITECT'S SIGNATURE

CLIENT'S SIGNATURE

SCALE : 1:100

DATE : ----

TOWER (A & B)
TYPICAL FLOOR
PLAN

dfA
DESIGN FORUM
OF ARCHITECTS
www.dfa.in
C - 10, SECTOR - 3, NOIDA - 201301
(NCR DELHI) INDIA
TEL : +91 120 460 1000
FAX : +91 120 460 1000
dfaconsultants@gmail.com

DRG. NO.
102

REV.