


DOOR SCHEDULE				
S.NO.	TYPE	SIZE	CILL LEVEL	LINTEL LEVEL
1	D1	1200 X 2100	00	2100
2	FD	1200 X 2100	00	2100

WINDOW SCHEDULE	
1	W2 2400 X AS/STAIR CASE DETAIL

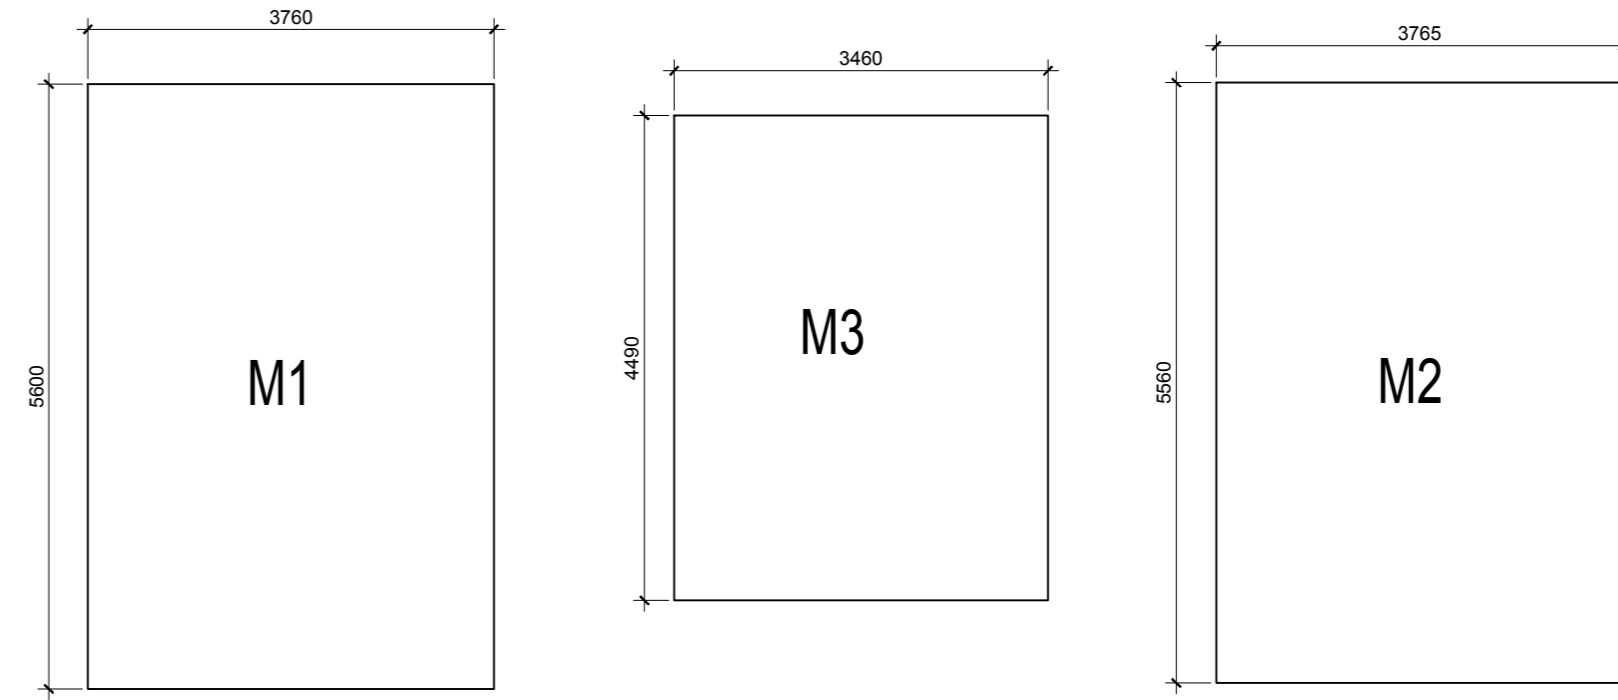

MUMTY AND MACH.ROOM AREA DIAGRAM

TOWER B - MUMTY AND MACH.ROOM					
TOTAL AREA	LENGTH	WIDTH	AREA	NO.	TOTAL
M1	3.76	5.6	21.056	1	21.056 SQMT.
M2	3.46	4.49	15.535	1	15.535 SQMT.
M3	3.765	5.56	20.933	1	20.933 SQMT.
<b>TOTAL (A)</b>				<b>3</b>	<b>57.525 SQMT.</b>

PROJECT:-  
**AS BUILT DRAWING**  
 OF GROUP HOUSING AT PLOT NO.-  
 THE ESFERA' AT SECTOR-37 C, GURGAON  
 FOR -----

ARCHITECT'S SIGNATURE

CLIENT'S SIGNATURE

SCALE : 1:100

DATE : ----

TOWER (B)  
 TERRACE PLAN



DRG. NO.  
 106

REV.