


BACK TO BACK PARKING HAS NOT TO BE CONSIDERED IN TOTAL PARKING CALCULATION SHEET
 BACK TO BACK PARKING SHALL BE ALLOTTED TO SINGLE OWNER

Handwritten notes:
 BHP
 ATPN
 AD
 FE

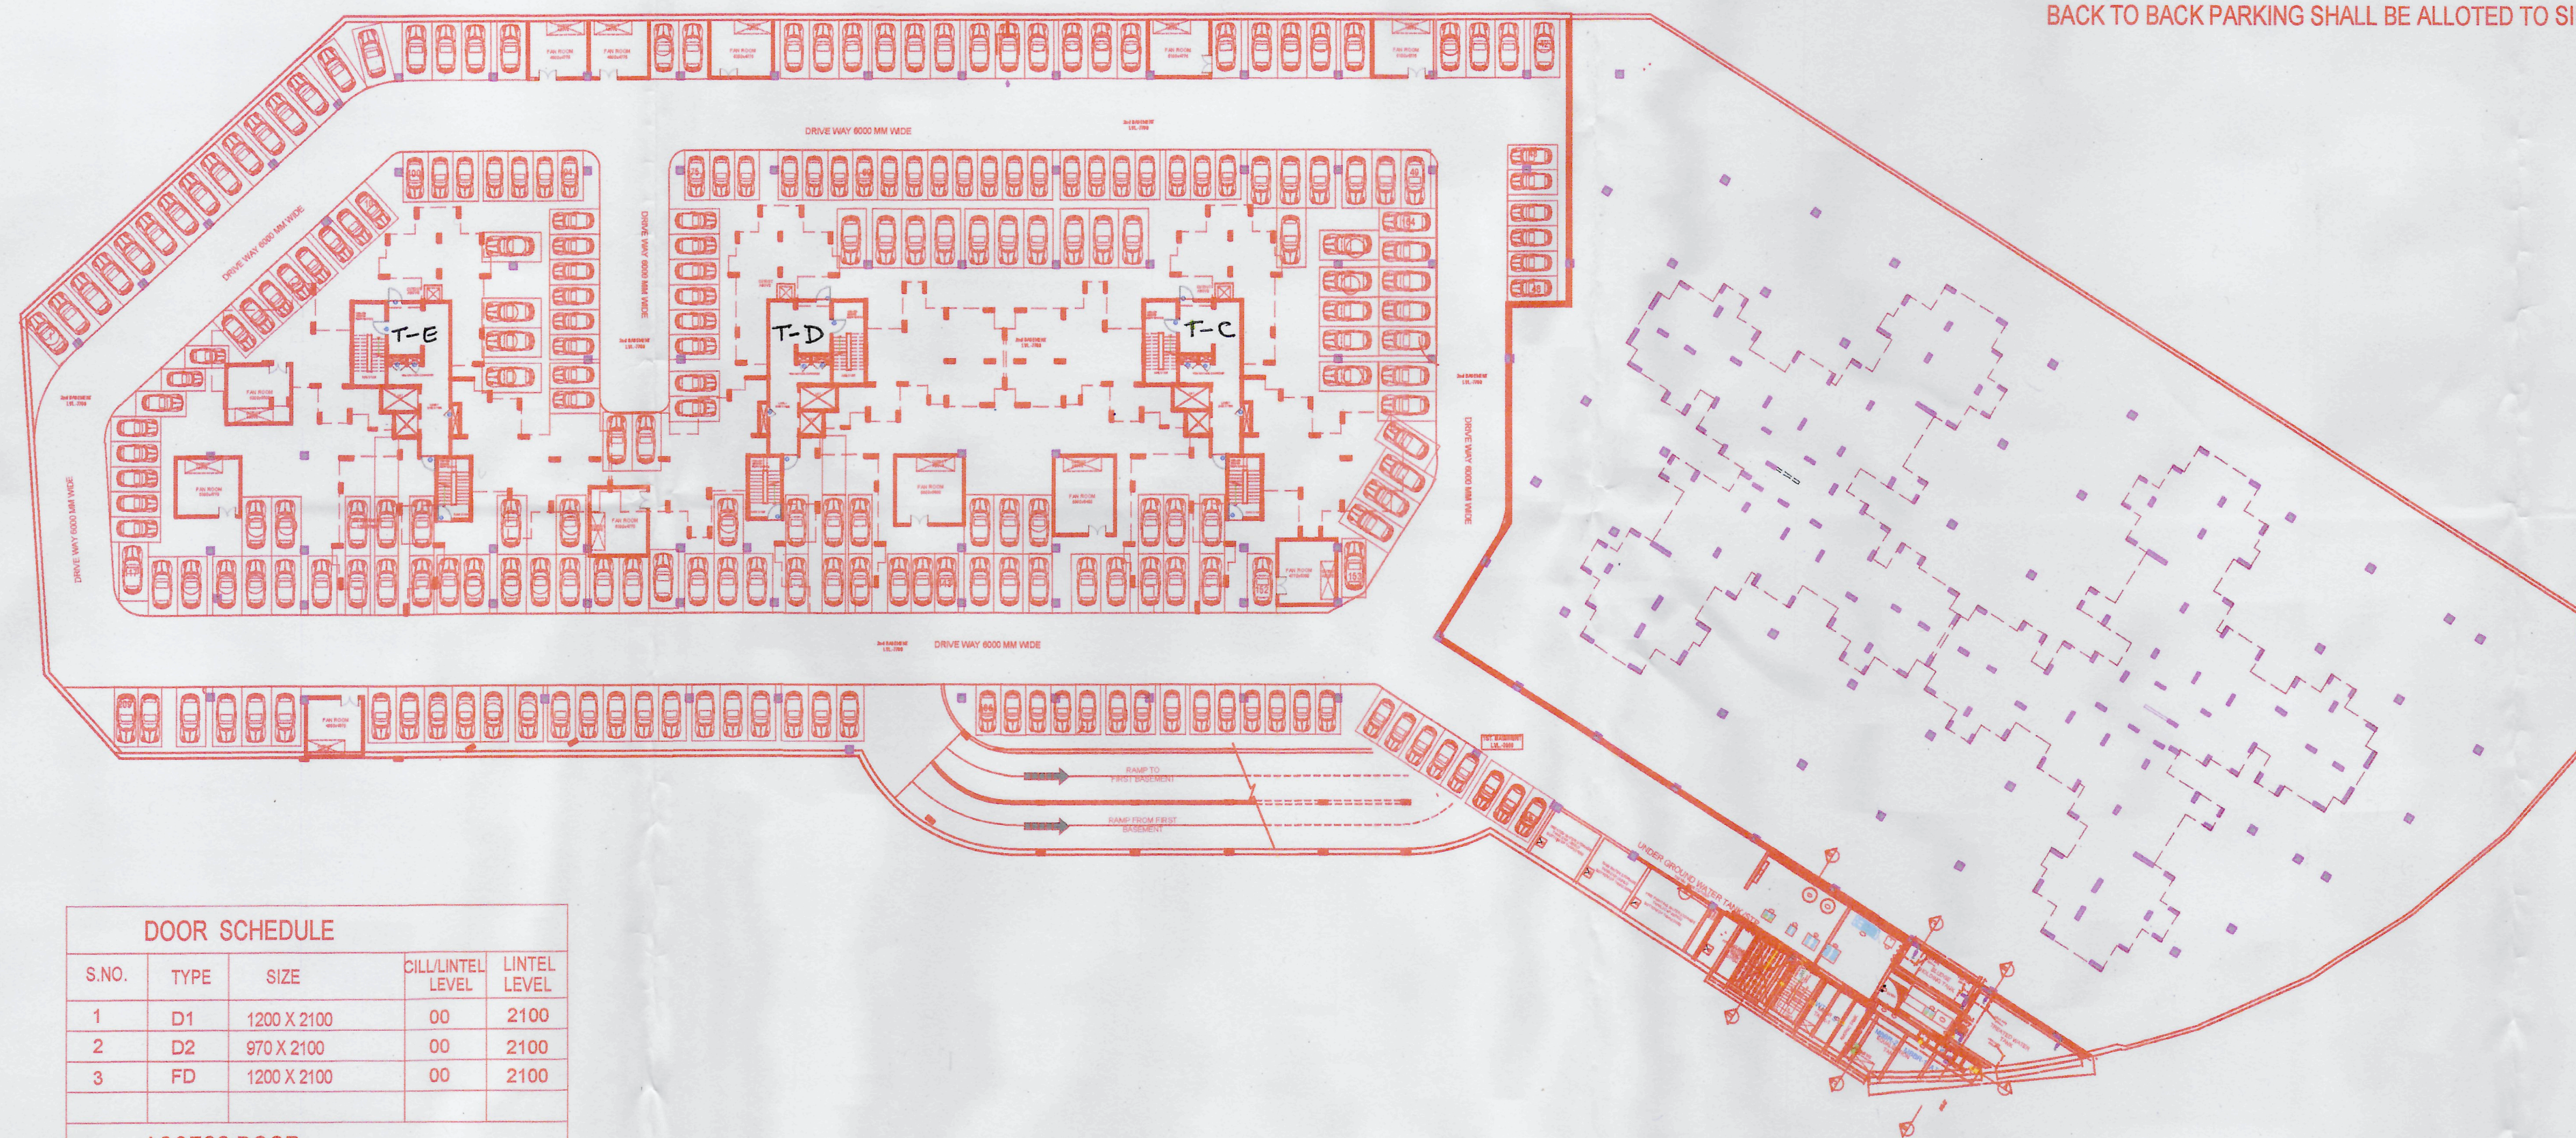

DOOR SCHEDULE				
S.NO.	TYPE	SIZE	ILLUMINEL LEVEL	LINTEL LEVEL
1	D1	1200 X 2100	00	2100
2	D2	970 X 2100	00	2100
3	FD	1200 X 2100	00	2100
ACCESS DOOR				
1	AD1	1200 X 1800	300	2100
2	AD2	1000 X 1800	300	2100

2nd. BASEMENT PLAN						
TOTAL AREA	LENGTH	WIDTH	AREA	NO.	TOTAL	
01	2.032	30.474	0.5	30.962	1	30.962 SQMT.
02	6.438	7.071	0.5	22.762	1	22.762 SQMT.
03	19.072	7.071	0	134.858	1	134.858 SQMT.
04	25.51	30.474	0	777.392	1	777.392 SQMT.
05	27.542	25.1	0.5	945.652	1	945.652 SQMT.
06	104.42	24.751	0	2584.499	1	2584.499 SQMT.
07	42.271	37.894	0	1601.817	1	1601.817 SQMT.
08	57.059	18.322	0	1045.435	1	1045.435 SQMT.
09	51.04	9.482	0	483.961	1	483.961 SQMT.
10	14.823	10.09	0	149.564	1	149.564 SQMT.
11	14.823	8.367	0.5	62.012	1	62.012 SQMT.
12	36.217	18.457	0	668.457	1	668.457 SQMT.
13	6.019	9.482	0.5	28.536	1	28.536 SQMT.
14	as/pline		0	157.000	1	157.000 SQMT.
15	34.493	11.85	0	408.742	1	408.742 SQMT.
16	15.352	11.85	0.5	90.961	1	90.961 SQMT.
16a	as/pline		0	8.335	1	8.335 SQMT.
TOTAL (A)						8600.945 SQMT.
TOTAL 2ND. BASEMENT AREA						8600.945 SQMT.

BASEMENT SERVICES						
LENGTH	WIDTH	AREA	NO.	TOTAL		
A	1.51	1.28	0	1.933	1	1.933 SQMT.
B	8.568	7.415	0	63.532	1	63.532 SQMT.
C	6.09	2.13	0	12.972	1	12.972 SQMT.
D	0.77	2.985	0	2.298	1	2.298 SQMT.
E	4.99	2.13	0	0.000	1	0.000 SQMT.
F	2.86	1.5	0	4.290	1	4.290 SQMT.
G	3.16	5.56	0	17.570	1	17.570 SQMT.
H	10.49	5.455	0	57.223	1	57.223 SQMT.
I	5.66	5.46	0	30.904	1	30.904 SQMT.
J	5.56	5.455	0	30.330	1	30.330 SQMT.
K	5.56	5.455	0	30.330	1	30.330 SQMT.
L	5.76	5.23	0	30.125	2	60.250 SQMT.
M	5.11	5.149	0	26.311	1	26.311 SQMT.
N	5.23	6.06	0	31.694	1	31.694 SQMT.
O	6.11	6.06	0	37.027	1	37.027 SQMT.
P	5.46	6.91	0	37.729	1	37.729 SQMT.
Q	5.23	5.76	0	30.125	1	30.125 SQMT.
R	42.656	11.853	0	505.602	1	505.602 SQMT.
S	15.013	11.853	0	177.949	1	177.949 SQMT.
T	as/pline		0	8.980	1	8.980 SQMT.
TOTAL (B)						1167.046 SQMT.

PROPOSED AREA FOR PARKING (TOTAL BASEMENT AREA - SERVICES AREA)	7433.899	SQMT.
PROPOSED AVAILABLE PARKING @ 32 SQMT/ECS AT BASEMENT 2	232.309	NOS.
SAY	233	NOS.
PROPOSED PARKING PROVIDED AT BASEMENT -2	168	NOS.

2nd. BASEMENT PLAN— ADDED WITHOUT SANCTION						
TOTAL AREA	LENGTH	WIDTH	AREA	NO.	TOTAL	
01	2.032	30.474	0.5	30.962	1	30.962 SQMT.
02	6.438	7.071	0.5	22.762	1	22.762 SQMT.
03	19.072	7.071	0	134.858	1	134.858 SQMT.
04	25.51	30.474	0	777.392	1	777.392 SQMT.
05	27.542	25.1	0.5	945.652	1	945.652 SQMT.
06	104.42	24.751	0	2584.499	1	2584.499 SQMT.
07	42.271	37.894	0	1601.817	1	1601.817 SQMT.
08	57.059	18.322	0	1045.435	1	1045.435 SQMT.
09	51.04	9.482	0	483.961	1	483.961 SQMT.
10	14.823	10.09	0	149.564	1	149.564 SQMT.
11	14.823	8.367	0.5	62.012	1	62.012 SQMT.
12	36.217	18.457	0	668.457	1	668.457 SQMT.
13	6.019	9.482	0.5	28.536	1	28.536 SQMT.
14	as/pline		0	157.000	1	157.000 SQMT.
15	34.493	11.85	0	408.742	1	408.742 SQMT.
16	15.352	11.85	0.5	90.961	1	90.961 SQMT.
16a	as/pline		0	8.335	1	8.335 SQMT.
TOTAL (A)						8600.945 SQMT.
TOTAL 2ND. BASEMENT AREA						8600.945 SQMT.



BASEMENT 02-AREA DIAGRAM

PROJECT:- AS BUILT DRAWING OF GROUP HOUSING AT PLOT NO.- THE ESFERA' AT SECTOR-37 C, GURGAON FOR	ARCHITECT'S SIGNATURE R. V. GANDHI ARCHITECT LIC. NO. CA/91/13852	CLIENT'S SIGNATURE For Imperia Structures Limited Authorized Signatory	SCALE : 1:100 DATE : --	BASEMENT-2.- PLAN	DRG. NO. 201 REV.
--	---	--	----------------------------	--------------------------	------------------------------------

