



ATP ✓
 AD ✓
 RF ✓

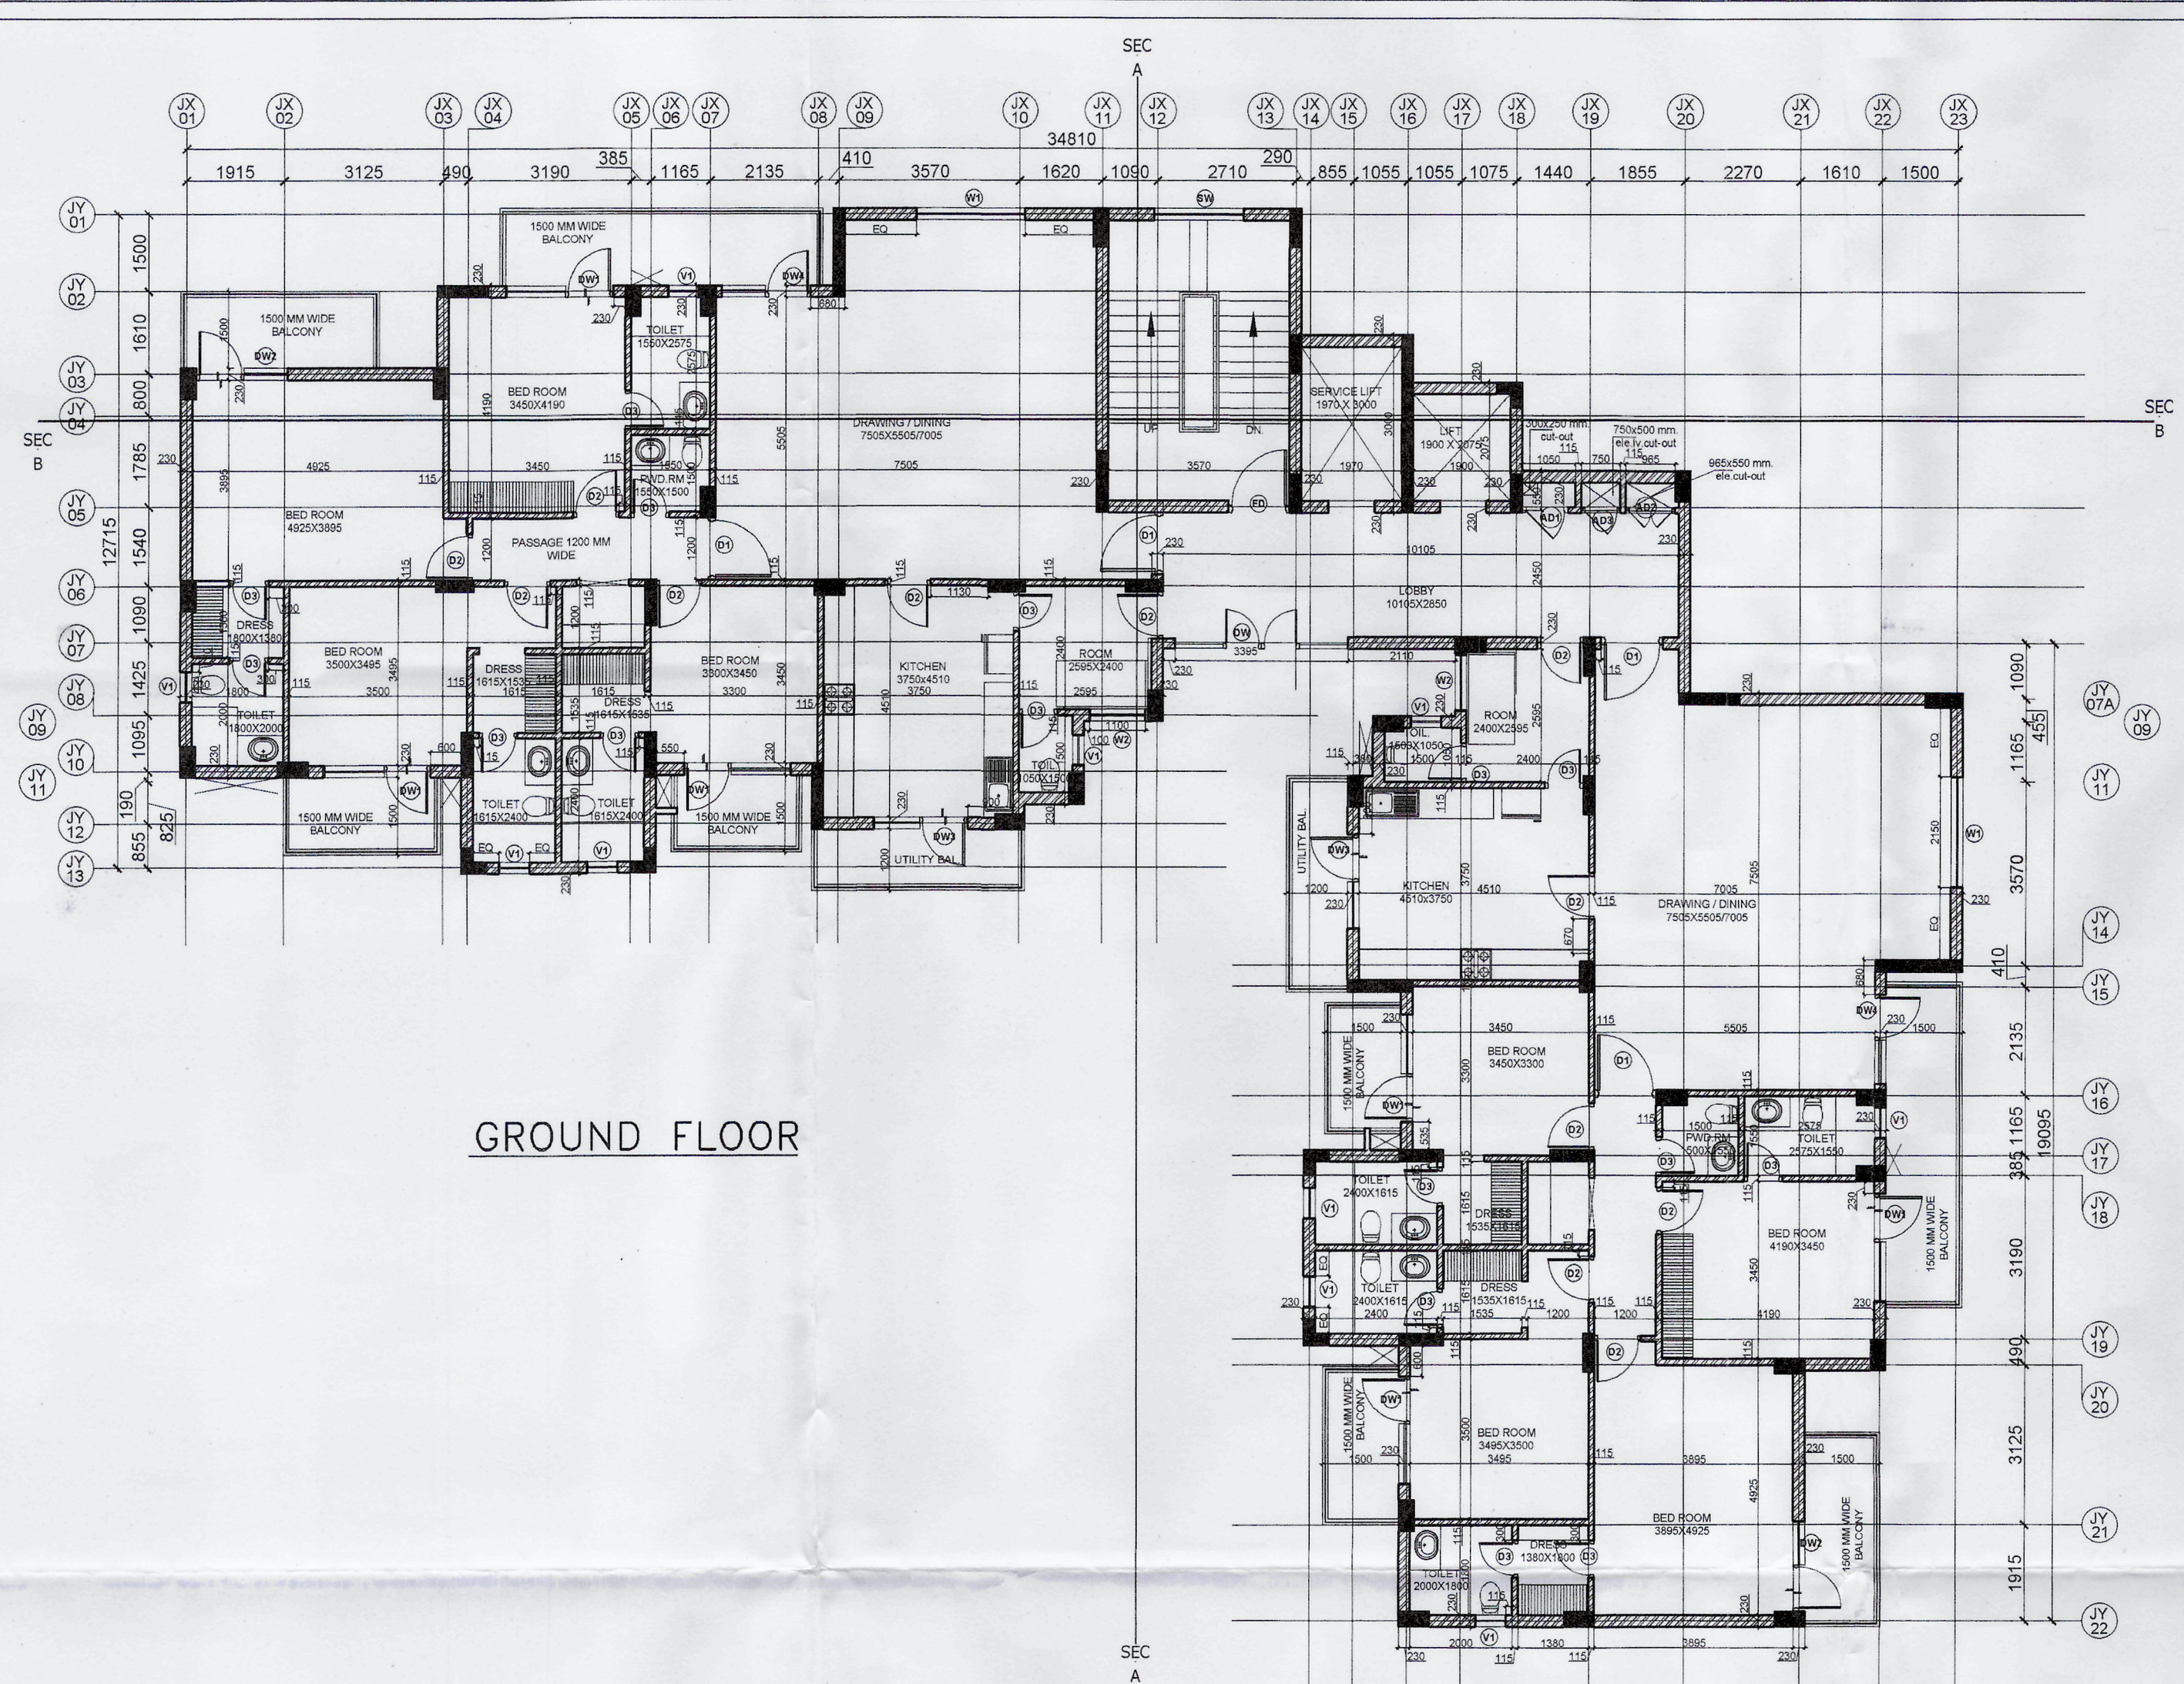

GROUND FLOOR

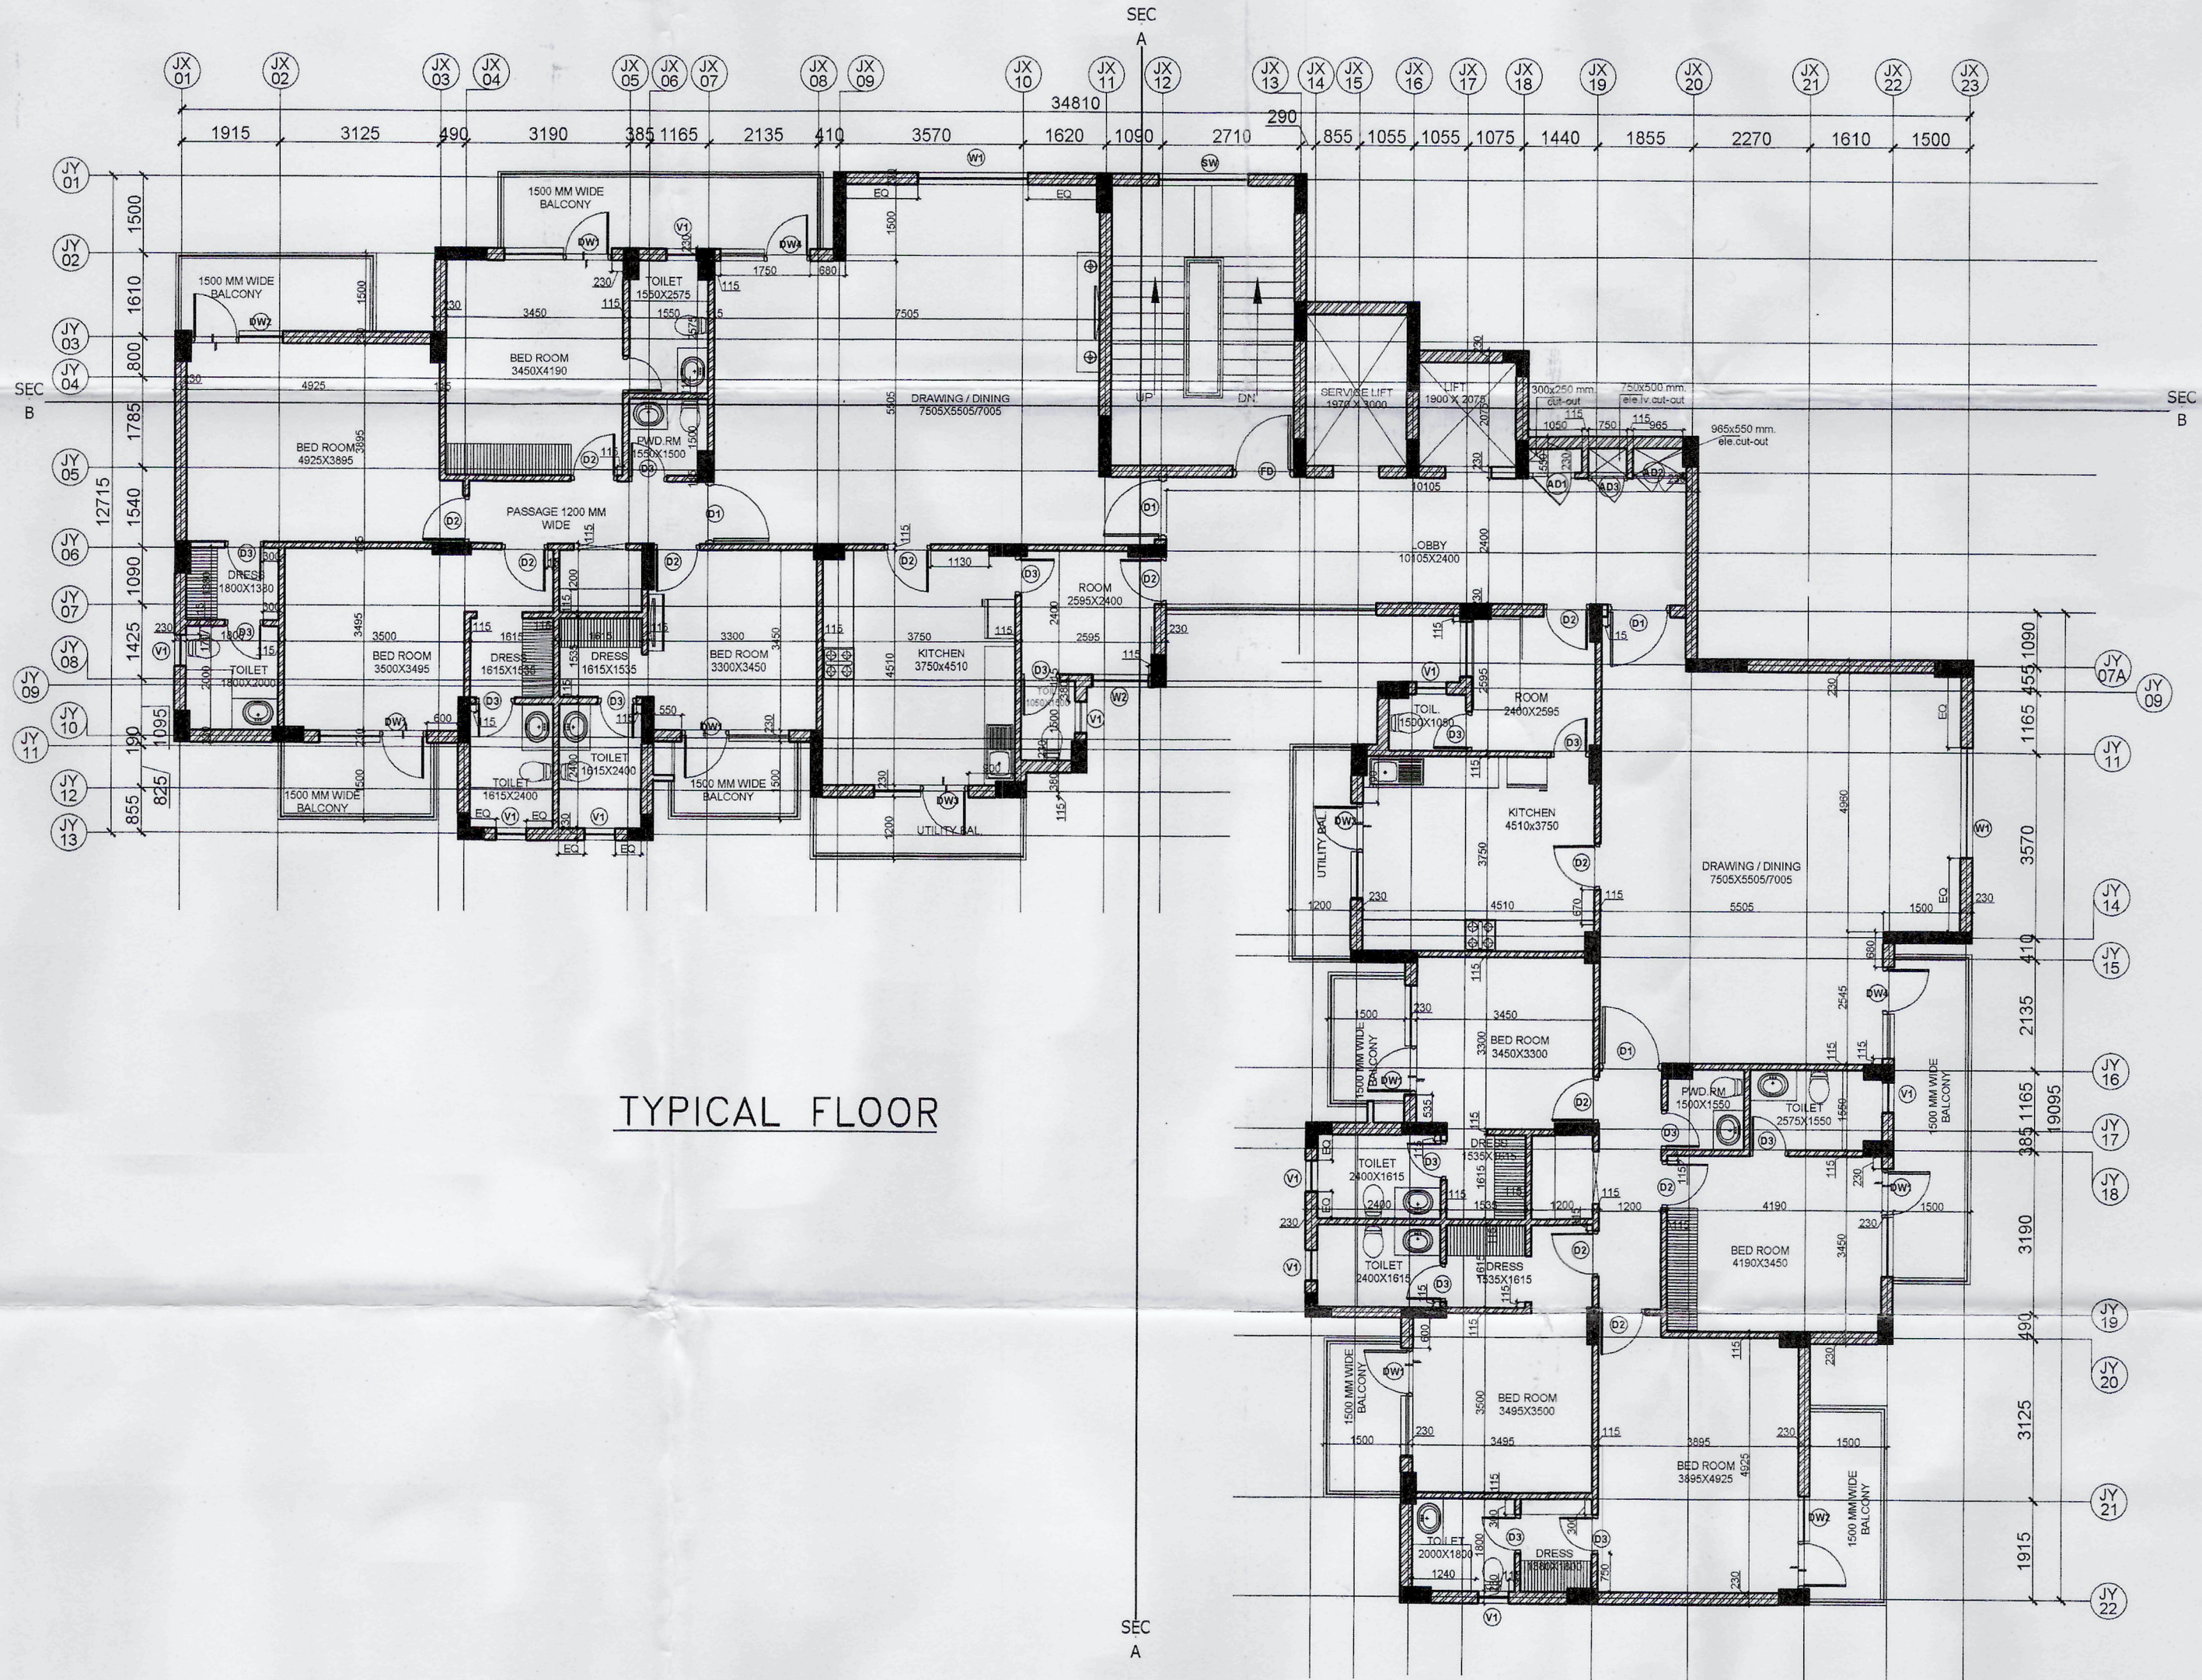

TYPICAL FLOOR

DOOR SCHEDULE							
S.NO.	TYPE	SIZE	CLL. LEVEL	LINTEL LEVEL	GROUND FLOOR	TYP. FLOOR	QTY.
1	D1	1200 X 2100	00	2100	02	02(4)	10
2	D2	800 X 2100	00	2100	06	06(4)	30
3	D3	750 X 2100	00	2100	08	08(4)	40
6	DW	3395 X 2400	00/300	2400	01		01
7	DW1	2100 X 2400	00/300	2400	03	03(4)	15
8	DW2	1800 X 2400	00/300	2400	01	01(4)	05
9	DW3	1800 X 2400	00/300	2400	01	01(4)	05
10	DW4	1750 X 2400	00/1000	2400	01	01(4)	05
11							

WINDOW SCHEDULE							
S.NO.	TYPE	SIZE	CLL. LEVEL	LINTEL LEVEL	GROUND FLOOR	TYP. FLOOR	QTY.
1	W1	2100 X 2100	300	2400	01	01(4)	05
2	W2	1100 X 2100	300	2400	01	01(4)	05
3	SW	1750 X 2100					
4	V1	600 X 1200	+1200	2400	05	05(4)	25

ACCESS DOOR							
S.NO.	TYPE	SIZE	CLL. LEVEL	LINTEL LEVEL	GROUND FLOOR	TYP. FLOOR	QTY.
1	AD1	800 X 1800	300	2100	01	01(4)	05
2	AD2	800 X 1800	300	2100	01	01(4)	05

PROJECT:- PROPOSED PROPOSED GROUP HOUSING AT PLOT NO.- THE ESPHERA' AT SECTOR-37 C, GURGAON FOR -----	ARCHITECT'S SIGNATURE RAJIV GANDHI ARCHITECT LIC. NO. CA/91/13852	CLIENT'S SIGNATURE Imperia Structures Limited Authorised Signatory	LOCAL AUTHORITY SUBMISSION SCALE : 1:100 DATE : ---	SUBMISSION DRAWING TOWER-(J) GROUND FLOOR TYPICAL FLOOR	DESIGN FORUM OF ARCHITECTS www.dfa.in C - 10, SECTOR - 3, NOIDA - 201301 (NCR DELHI) INDIA TEL. : +91 120 460 1000 FAX : +91 120 460 1000 dfaconsultants@gmail.com	DRG. NO. DFA/SUB/TOW./115 REV. <div style="text-align: center;"> </div>
---	--	--	---	--	---	--