

GROUND FLOOR PLAN

DOOR SCHEDULE


S.NO.	TYPE	SIZE	DILL/INTL LEVEL	INTL LEVEL
1	D1	1200 X 2100	00	2100
2	D2	1000 X 2100	00	2100
3	D3	900 X 2100	00	2100
4	D4	750 X 2100	00	2100
5	D4	750 X 2400	00	2400
6	DW	2500 X 2400 / 2100	00/300	2400
7	DW1	2100 X 2400 / 2100	00/300	2400
8	DW2	1800 X 2400 / 2100	00/300	2400
9	DW2	1750 X 2400 / 1850	00/1050	2400
10	DW3	1570 X 2400 / 1850	00/1050	2400
11	DW4	1300 X 2400 / 1850	00/1050	2400
12	FD	1200 X 2100	00	2100

WINDOW SCHEDULE

S	W	2400 X ASSISTAIR CASE DETAIL		
1	W1	1800 X 2100	300	2400
2	W2	1800 X 2100	300	2400
3	W3	1400 X 2100	300	2400
4	W4	1200 X 1350	1050	2400
5	W5	1000 X 2100	300	2400
6	V	800 X 1100	1000	2400
7	V1	450 X 1100	1000	2400

ACCESS DOOR

1	AD1	1200 X 1800	300	2100
2	AD2	1000 X 1800	300	2100

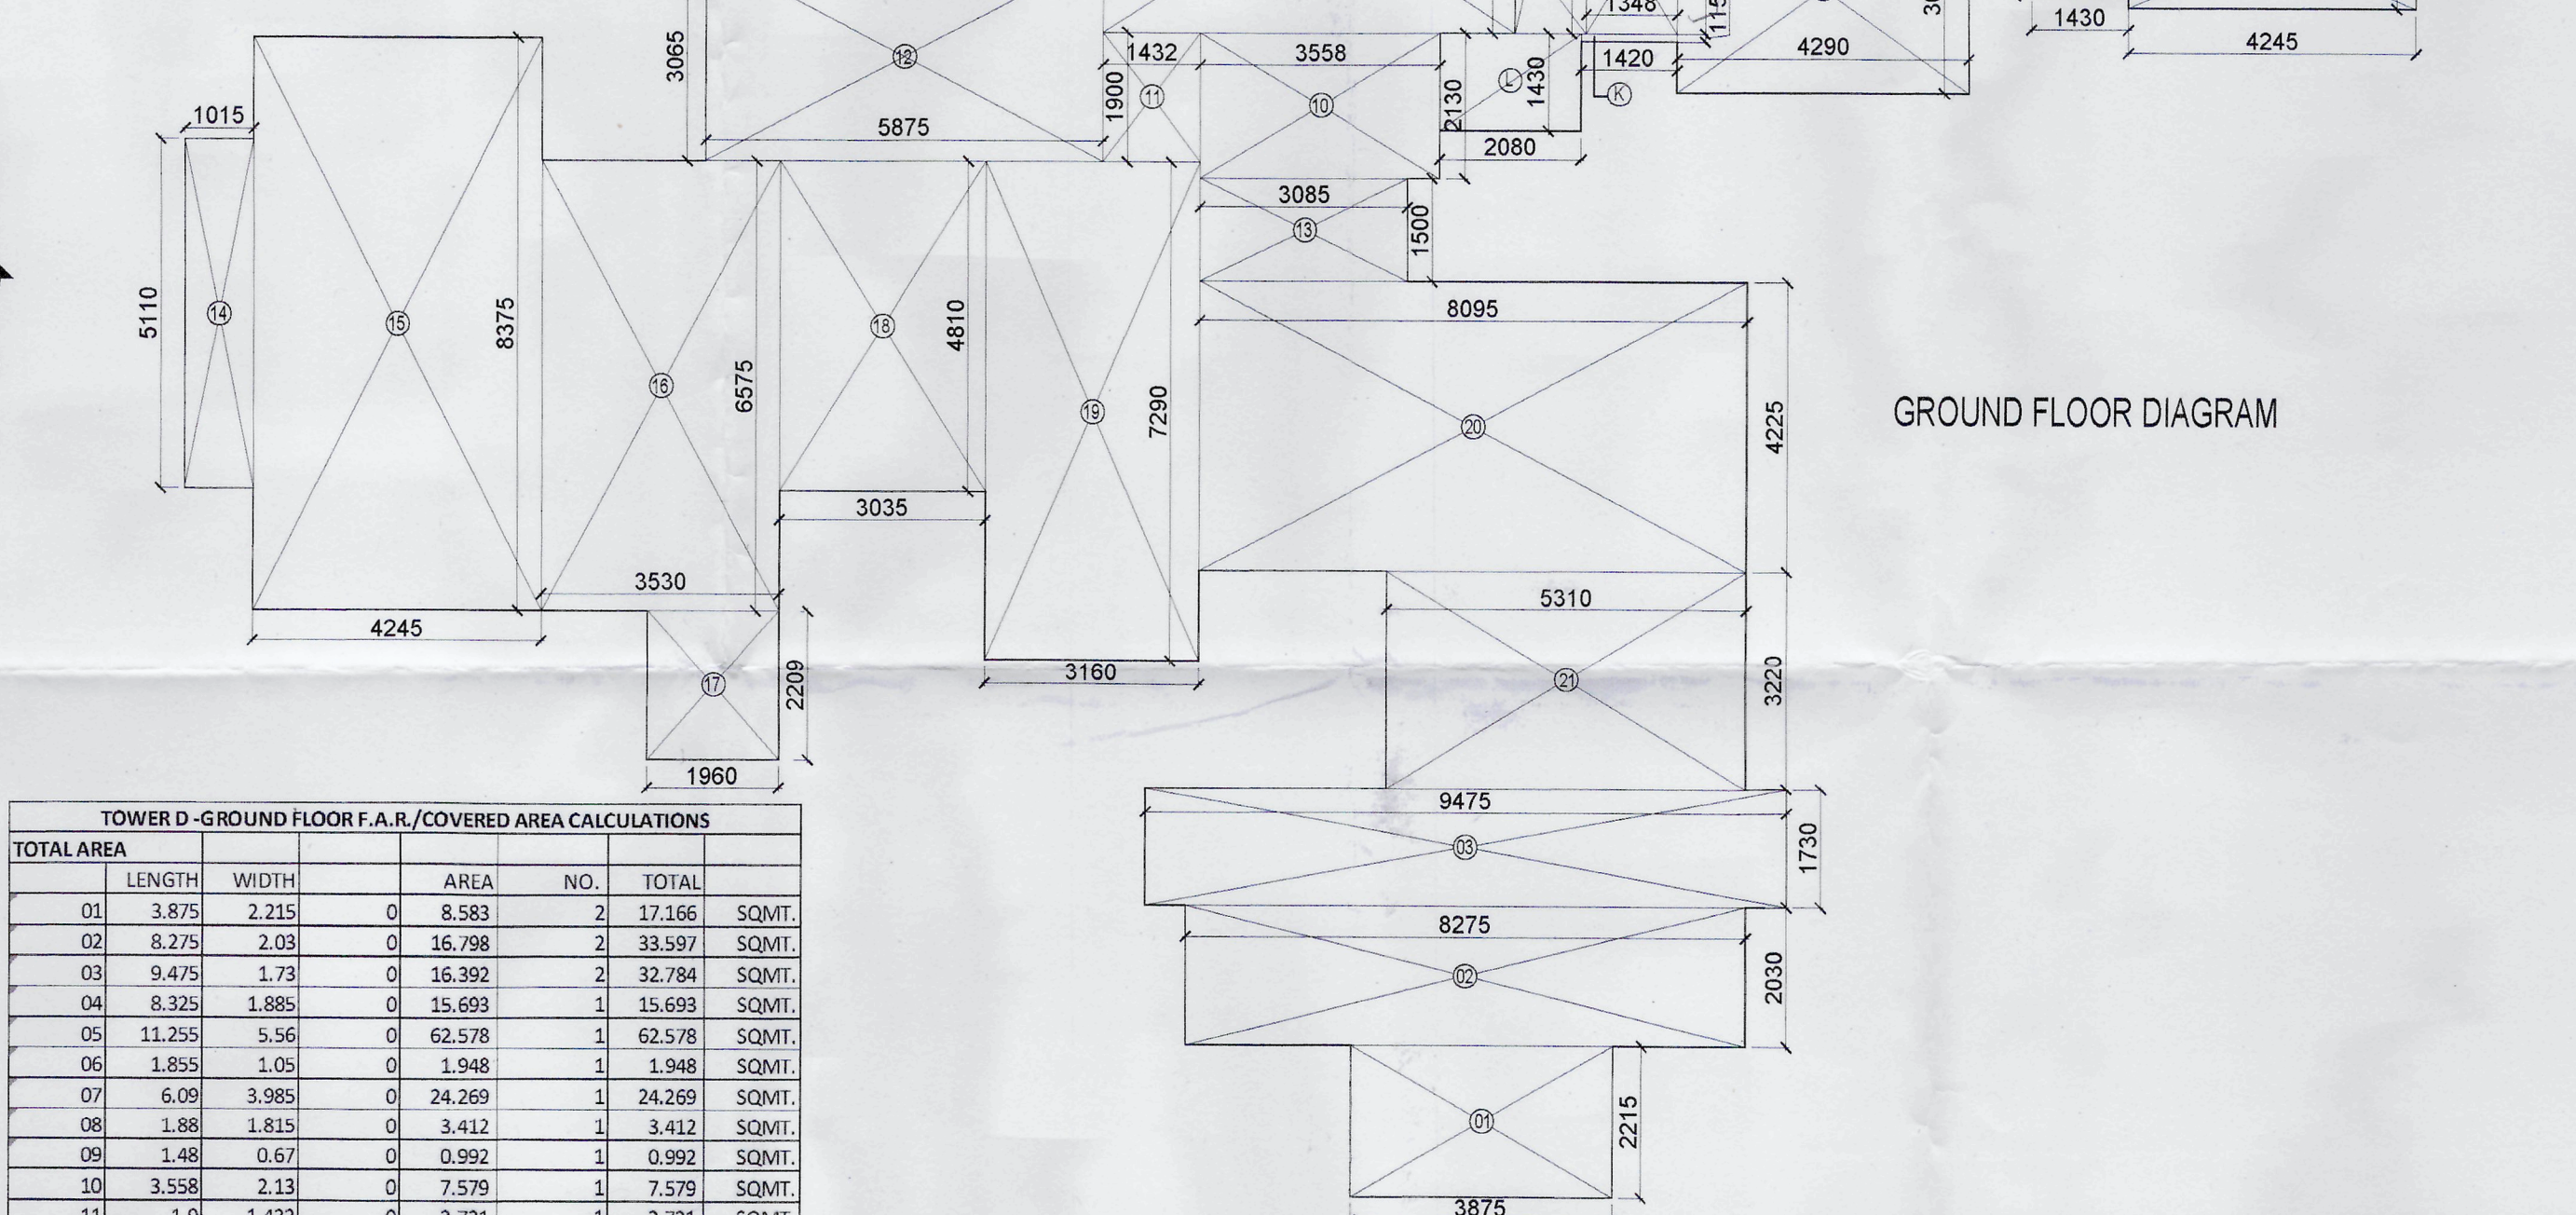

GROUND FLOOR DIAGRAM

TOWER D - GROUND FLOOR F.A.R./COVERED AREA CALCULATIONS

TOTAL AREA	LENGTH	WIDTH	AREA	NO.	TOTAL
01	3.875	2.215	0	8.583	2 17.166 SQMT.
02	8.275	2.03	0	16.798	2 33.597 SQMT.
03	9.475	1.73	0	16.392	2 32.784 SQMT.
04	8.325	1.885	0	15.693	1 15.693 SQMT.
05	11.255	5.56	0	62.578	1 62.578 SQMT.
06	1.855	1.05	0	1.948	1 1.948 SQMT.
07	6.09	3.985	0	24.269	1 24.269 SQMT.
08	1.88	1.815	0	3.412	1 3.412 SQMT.
09	1.48	0.67	0	0.992	1 0.992 SQMT.
10	3.558	2.13	0	7.579	1 7.579 SQMT.
11	1.9	1.432	0	2.721	1 2.721 SQMT.
12	5.875	3.065	0	18.007	1 18.007 SQMT.
13	3.085	1.5	0	4.628	1 4.628 SQMT.
14	5.11	1.015	0	5.187	1 5.187 SQMT.
15	8.375	4.245	0	35.552	1 35.552 SQMT.
16	6.575	3.53	0	23.210	1 23.210 SQMT.
17	2.215	1.96	0	4.341	1 4.341 SQMT.
18	4.81	3.035	0	14.598	1 14.598 SQMT.
19	7.29	3.16	0	23.036	1 23.036 SQMT.
20	8.095	4.225	0	34.201	1 34.201 SQMT.
21	5.31	3.22	0	17.098	1 17.098 SQMT.
TOTAL (A)					382.595 SQMT.
FIRE STAIRCASE (free of far)					
	LENGTH	WIDTH	AREA	NO.	TOTAL
K	2.7	5.56	0	15.012	1 15.012 SQMT.
TOTAL (B)					15.012 SQMT.
TOTAL FAR AREA - A+B					367.583 SQMT.
STILT AREA					
A	1.05	5.11	0	5.366	1 5.366 SQMT.
B	7.775	6.575	0	51.121	1 51.121 SQMT.
C	1.8	4.245	0	7.641	1 7.641 SQMT.
D	1.43	1.615	0	2.309	1 2.309 SQMT.
E	2.215	1.96	0	4.341	1 4.341 SQMT.
F	3.035	4.81	0	14.598	1 14.598 SQMT.
G	1.43	1.785	0	2.553	1 2.553 SQMT.
H	4.29	3.065	0	13.149	1 13.149 SQMT.
I	1.348	2.2	0	2.966	1 2.966 SQMT.
J	2.13	1.05	0	2.237	1 2.237 SQMT.
K	1.42	0.115	0	0.163	1 0.163 SQMT.
L	2.08	1.43	0	2.974	1 2.974 SQMT.
TOTAL (A)					109.418 SQMT.
TOTAL STILT AREA					109.418 SQMT.

TOWER D

S.NO.	ATTRIBUTES	SANCTIONED F.A.R. (SQMT.)	ACHIEVED F.A.R. (SQMT.)	ADDED AREA WITHOUT SANCTION
1	GROUND FLOOR	373.78	367.583	-6.197
2	1ST. FLOOR	451.956	451.492	0.000
3	2ND. FLOOR	451.956	451.492	0.000
4	3RD. FLOOR	451.956	451.492	0.000
5	4TH. FLOOR	451.956	451.492	0.000
6	5TH. FLOOR	451.956	451.492	0.000
7	6TH. FLOOR	451.956	451.492	0.000
8	7TH. FLOOR	451.956	451.492	0.000
9	8TH. FLOOR	451.956	451.492	0.000
10	9TH. FLOOR	451.956	451.492	0.000
11	10TH. FLOOR	451.956	451.492	0.000
12	11TH. FLOOR	451.956	451.492	0.000
13	12TH. FLOOR	451.956	451.492	0.000
14	13TH. FLOOR	451.956	451.492	0.000
15	14TH. FLOOR	451.956	451.492	0.000
16	15TH. FLOOR	451.956	451.492	0.000
17	16TH. FLOOR	451.956	451.492	0.000
18	17TH. FLOOR	451.956	451.492	0.000
19	18TH. FLOOR	451.956	451.492	0.000
20	19TH. FLOOR	451.956	451.492	0.000
21	20TH. FLOOR	451.956	451.492	0.000
22	21TH. FLOOR	451.956	451.492	0.000
23	22TH. FLOOR	451.956	451.492	0.000
24	23TH. FLOOR	451.956	451.492	0.000
21	TERRACE			
TOTAL		10768.768	10751.898	-6.197

PROJECT:- PROPOSED

ARCHITECT'S SIGNATURE: **RAJESH KANDHI ARCHITECT LIC. No. 04/91/13652**

CLIENT'S SIGNATURE: **For Imperia Structures Limited Authorised Signatory**

LOCAL AUTHORITY SUBMISSION

SCALE : 1:100

DATE : ---

SUBMISSION DRAWING

TOWER (D) GROUND FLOOR PLAN

DRG. NO. DFA/SUB/TOW./115

REV.

DESIGN FORUM OF ARCHITECTS
C-10, SECTOR - 3, NOIDA - 201301
(NCR DELHI) INDIA
TEL : +91 120 460 1000
FAX : +91 120 460 1000
dfeconsultants@gmail.com