

TYPICAL FLOOR PLAN

DOOR SCHEDULE

| S.NO. | TYPE | SIZE | QUANTITY | LEVEL | LEVEL |
|-------|------|--------------------|----------|-------|-------|
| 1 | D1 | 1200 X 2100 | 00 | 00 | 2100 |
| 2 | D2 | 1000 X 2100 | 00 | 00 | 2100 |
| 3 | D3 | 800 X 2100 | 00 | 00 | 2100 |
| 4 | D4 | 750 X 2100 | 00 | 00 | 2100 |
| 5 | D4' | 750 X 2400 | 00 | 00 | 2400 |
| 6 | DW | 2500 X 2400 / 2100 | 00/300 | 00 | 2400 |
| 7 | DW1 | 2100 X 2400 / 2100 | 00/300 | 00 | 2400 |
| 8 | DW2 | 1800 X 2400 / 2100 | 00/300 | 00 | 2400 |
| 9 | DW2' | 1750 X 2400 / 1350 | 00/1050 | 00 | 2400 |
| 10 | DW3 | 1570 X 2400 / 1350 | 00/1050 | 00 | 2400 |
| 11 | DW4 | 1300 X 2400 / 1350 | 00/1050 | 00 | 2400 |
| 12 | FD | 1200 X 2100 | 00 | 00 | 2100 |

WINDOW SCHEDULE

| S | W | 2400 X ASSISTAIR CASE DETAIL | 300 | 2400 |
|---|----|------------------------------|------|------|
| 1 | W1 | 1820 X 2100 | 300 | 2400 |
| 2 | W2 | 1600 X 2100 | 300 | 2400 |
| 3 | W3 | 1400 X 2100 | 300 | 2400 |
| 4 | W4 | 1200 X 1350 | 1050 | 2400 |
| 5 | W5 | 1000 X 2100 | 300 | 2400 |
| 6 | W6 | 800 X 1100 | 1000 | 2400 |
| 7 | V | 800 X 1100 | 1000 | 2400 |
| 8 | V1 | 450 X 1100 | 1000 | 2400 |

ACCESS DOOR

| | | | | |
|---|-----|-------------|-----|------|
| 1 | AD1 | 1200 X 1800 | 300 | 2100 |
| 2 | AD2 | 1000 X 1800 | 300 | 2100 |

TOWER D - TYPICAL FLOOR F.A.R./COVERED AREA CALCULATIONS

| TOTAL AREA | LENGTH | WIDTH | AREA | NO. | TOTAL | | |
|------------------|--------|-------|------|--------|----------------|--------------|-------|
| 01 | 1.05 | 5.31 | 0 | 5.366 | 2 | 10.731 | SQMT. |
| 02 | 1.8 | 4.245 | 0 | 7.641 | 2 | 15.282 | SQMT. |
| 03 | 1.43 | 1.615 | 0 | 2.309 | 1 | 2.309 | SQMT. |
| 04 | 7.775 | 6.575 | 0 | 51.121 | 2 | 102.241 | SQMT. |
| 05 | 2.215 | 1.96 | 0 | 4.341 | 2 | 8.683 | SQMT. |
| 06 | 2.535 | 3.16 | 0 | 8.011 | 1 | 8.011 | SQMT. |
| 07 | 6.195 | 4.8 | 0 | 29.736 | 1 | 29.736 | SQMT. |
| 08 | 3.065 | 2.86 | 0 | 8.766 | 1 | 8.766 | SQMT. |
| 09 | 3.078 | 2.315 | 0 | 7.126 | 1 | 7.126 | SQMT. |
| 10 | 1.315 | 1.658 | 0 | 2.180 | 1 | 2.180 | SQMT. |
| 11 | 3.875 | 2.215 | 0 | 8.583 | 2 | 17.166 | SQMT. |
| 12 | 2.03 | 8.275 | 0 | 16.798 | 2 | 33.597 | SQMT. |
| 13 | 1.73 | 9.475 | 0 | 16.392 | 2 | 32.784 | SQMT. |
| 14 | 7.445 | 5.31 | 0 | 39.533 | 2 | 79.066 | SQMT. |
| 15 | 4.955 | 2.785 | 0 | 13.800 | 1 | 13.800 | SQMT. |
| 16 | 5.412 | 5.415 | 0 | 29.306 | 1 | 29.306 | SQMT. |
| 17 | 1.88 | 4.88 | 0 | 9.174 | 1 | 9.174 | SQMT. |
| 18 | 3.735 | 1.48 | 0 | 5.528 | 1 | 5.528 | SQMT. |
| 19 | 2.515 | 3.065 | 0 | 7.708 | 1 | 7.708 | SQMT. |
| 20 | 4.99 | 0.7 | 0 | 3.493 | 1 | 3.493 | SQMT. |
| 21 | 4.517 | 1.5 | 0 | 6.776 | 1 | 6.776 | SQMT. |
| 22 | 4.763 | 4.81 | 0 | 22.910 | 1 | 22.910 | SQMT. |
| 23 | 4.217 | 3.08 | 0 | 12.988 | 1 | 12.988 | SQMT. |
| 24 | 5.945 | 1.145 | 0 | 6.807 | 1 | 6.807 | SQMT. |
| 25 | 3.16 | 1.335 | 0 | 4.219 | 1 | 4.219 | SQMT. |
| TOTAL (A) | | | | | 480.386 | SQMT. | |

LIFT WELL

| LENGTH | WIDTH | AREA | NO. | TOTAL | | | |
|------------------|-------|------|-----|-------|--------------|--------------|-------|
| B | 1.9 | 1.9 | 0 | 3.610 | 1 | 3.610 | SQMT. |
| C | 1.9 | 3 | 0 | 5.700 | 1 | 5.700 | SQMT. |
| TOTAL (B) | | | | | 9.310 | SQMT. | |


FIRE STAIRCASE (free of far)

| LENGTH | WIDTH | AREA | NO. | TOTAL | | | |
|------------------|-------|------|-----|--------|---------------|--------------|-------|
| H | 2.7 | 5.1 | 0 | 13.770 | 1 | 13.770 | SQMT. |
| TOTAL (C) | | | | | 13.770 | SQMT. | |


CUT-OUT

| LENGTH | WIDTH | AREA | NO. | TOTAL | | | |
|------------------|-------|-------|-----|-------|--------------|--------------|-------|
| C | 1.55 | 1.285 | 0 | 1.992 | 1 | 1.992 | SQMT. |
| D | 0.5 | 1.5 | 0 | 0.750 | 1 | 0.750 | SQMT. |
| E | 0.5 | 1.055 | 0 | 0.528 | 1 | 0.528 | SQMT. |
| F | 2.525 | 0.54 | 0 | 1.364 | 1 | 1.364 | SQMT. |
| G | 1.27 | 0.93 | 0 | 1.181 | 1 | 1.181 | SQMT. |
| TOTAL (D) | | | | | 5.814 | SQMT. | |

TOTAL FAR AREA = A + (B+C+D) = 451.492 SQMT.

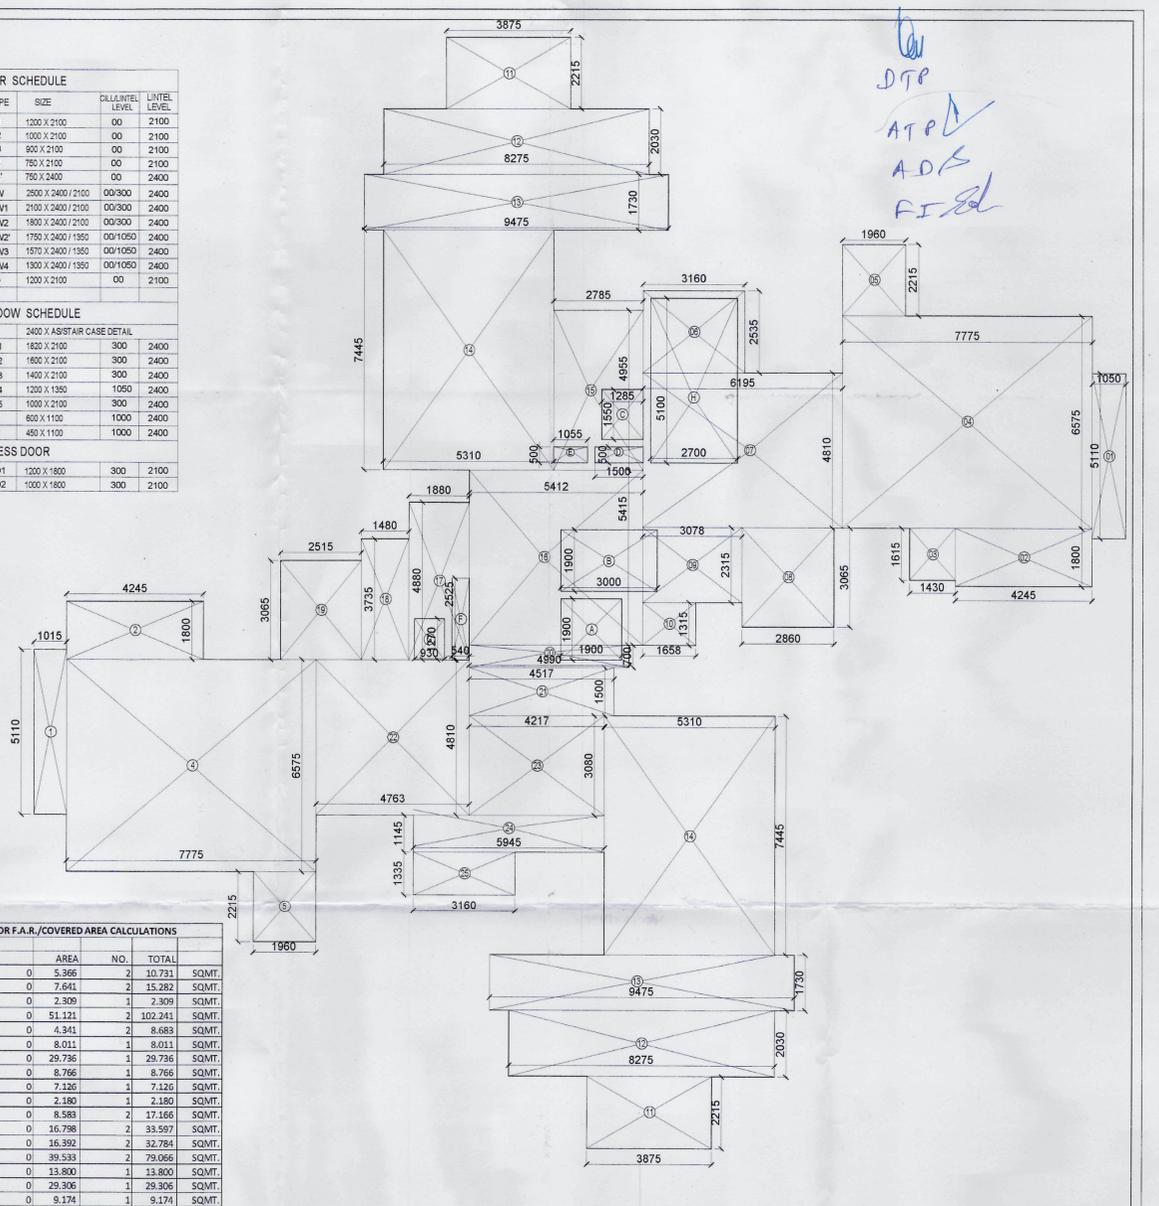

DTP
ATPL
ADS
FIS

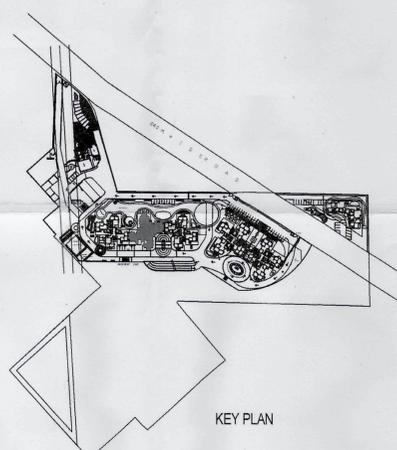

KEY PLAN

| | | | | | |
|--------------------------------------------------------------------------------------------------------------------------------------------------------------------------------------------------------------------|------------------------------------------------------------------------------------------------|-----------------------------------------------------------------------------------------------------------------|---------------------------------------------------------------------------|-------------------------------------------------------------------|------------------------------------------------------------------------------------------------|
| <p>PROJECT:- PROPOSED</p> <p>PROPOSED GROUP HOUSING AT PLOT NO.- THE ESPHERA' AT SECTOR-37 C, GURGAON FOR -----</p> | <p>ARCHITECT'S SIGNATURE</p> <p>RAJIV BANSAL ARCHITECT LIC. No. CA/11/13852</p> | <p>CLIENT'S SIGNATURE</p> <p>For Imperia Structures Limited <i>[Signature]</i> Authorised Signatory</p> | <p>LOCAL AUTHORITY SUBMISSION</p> <p>SCALE : 1:100</p> <p>DATE : ----</p> | <p>SUBMISSION DRAWING</p> <p>TOWER (D) TYPICAL FLOOR PLAN</p> | <p>DRG. NO.</p> <p>DFA/SUB/TOW./115</p> <p>REV.</p> <p style="text-align: center;">N ↑</p> |
| <p>dFA DESIGN FORUM OF ARCHITECTS www.dfa.in</p> <p>C-10, SECTOR-3, NOIDA - 201301 (NCR DELHI) INDIA TEL : +91 120 460 9000 FAX : +91 120 460 9000 dfaconsultants@gmail.com</p> | | | | | |