


DTP
ATP
AD 8
FF-80

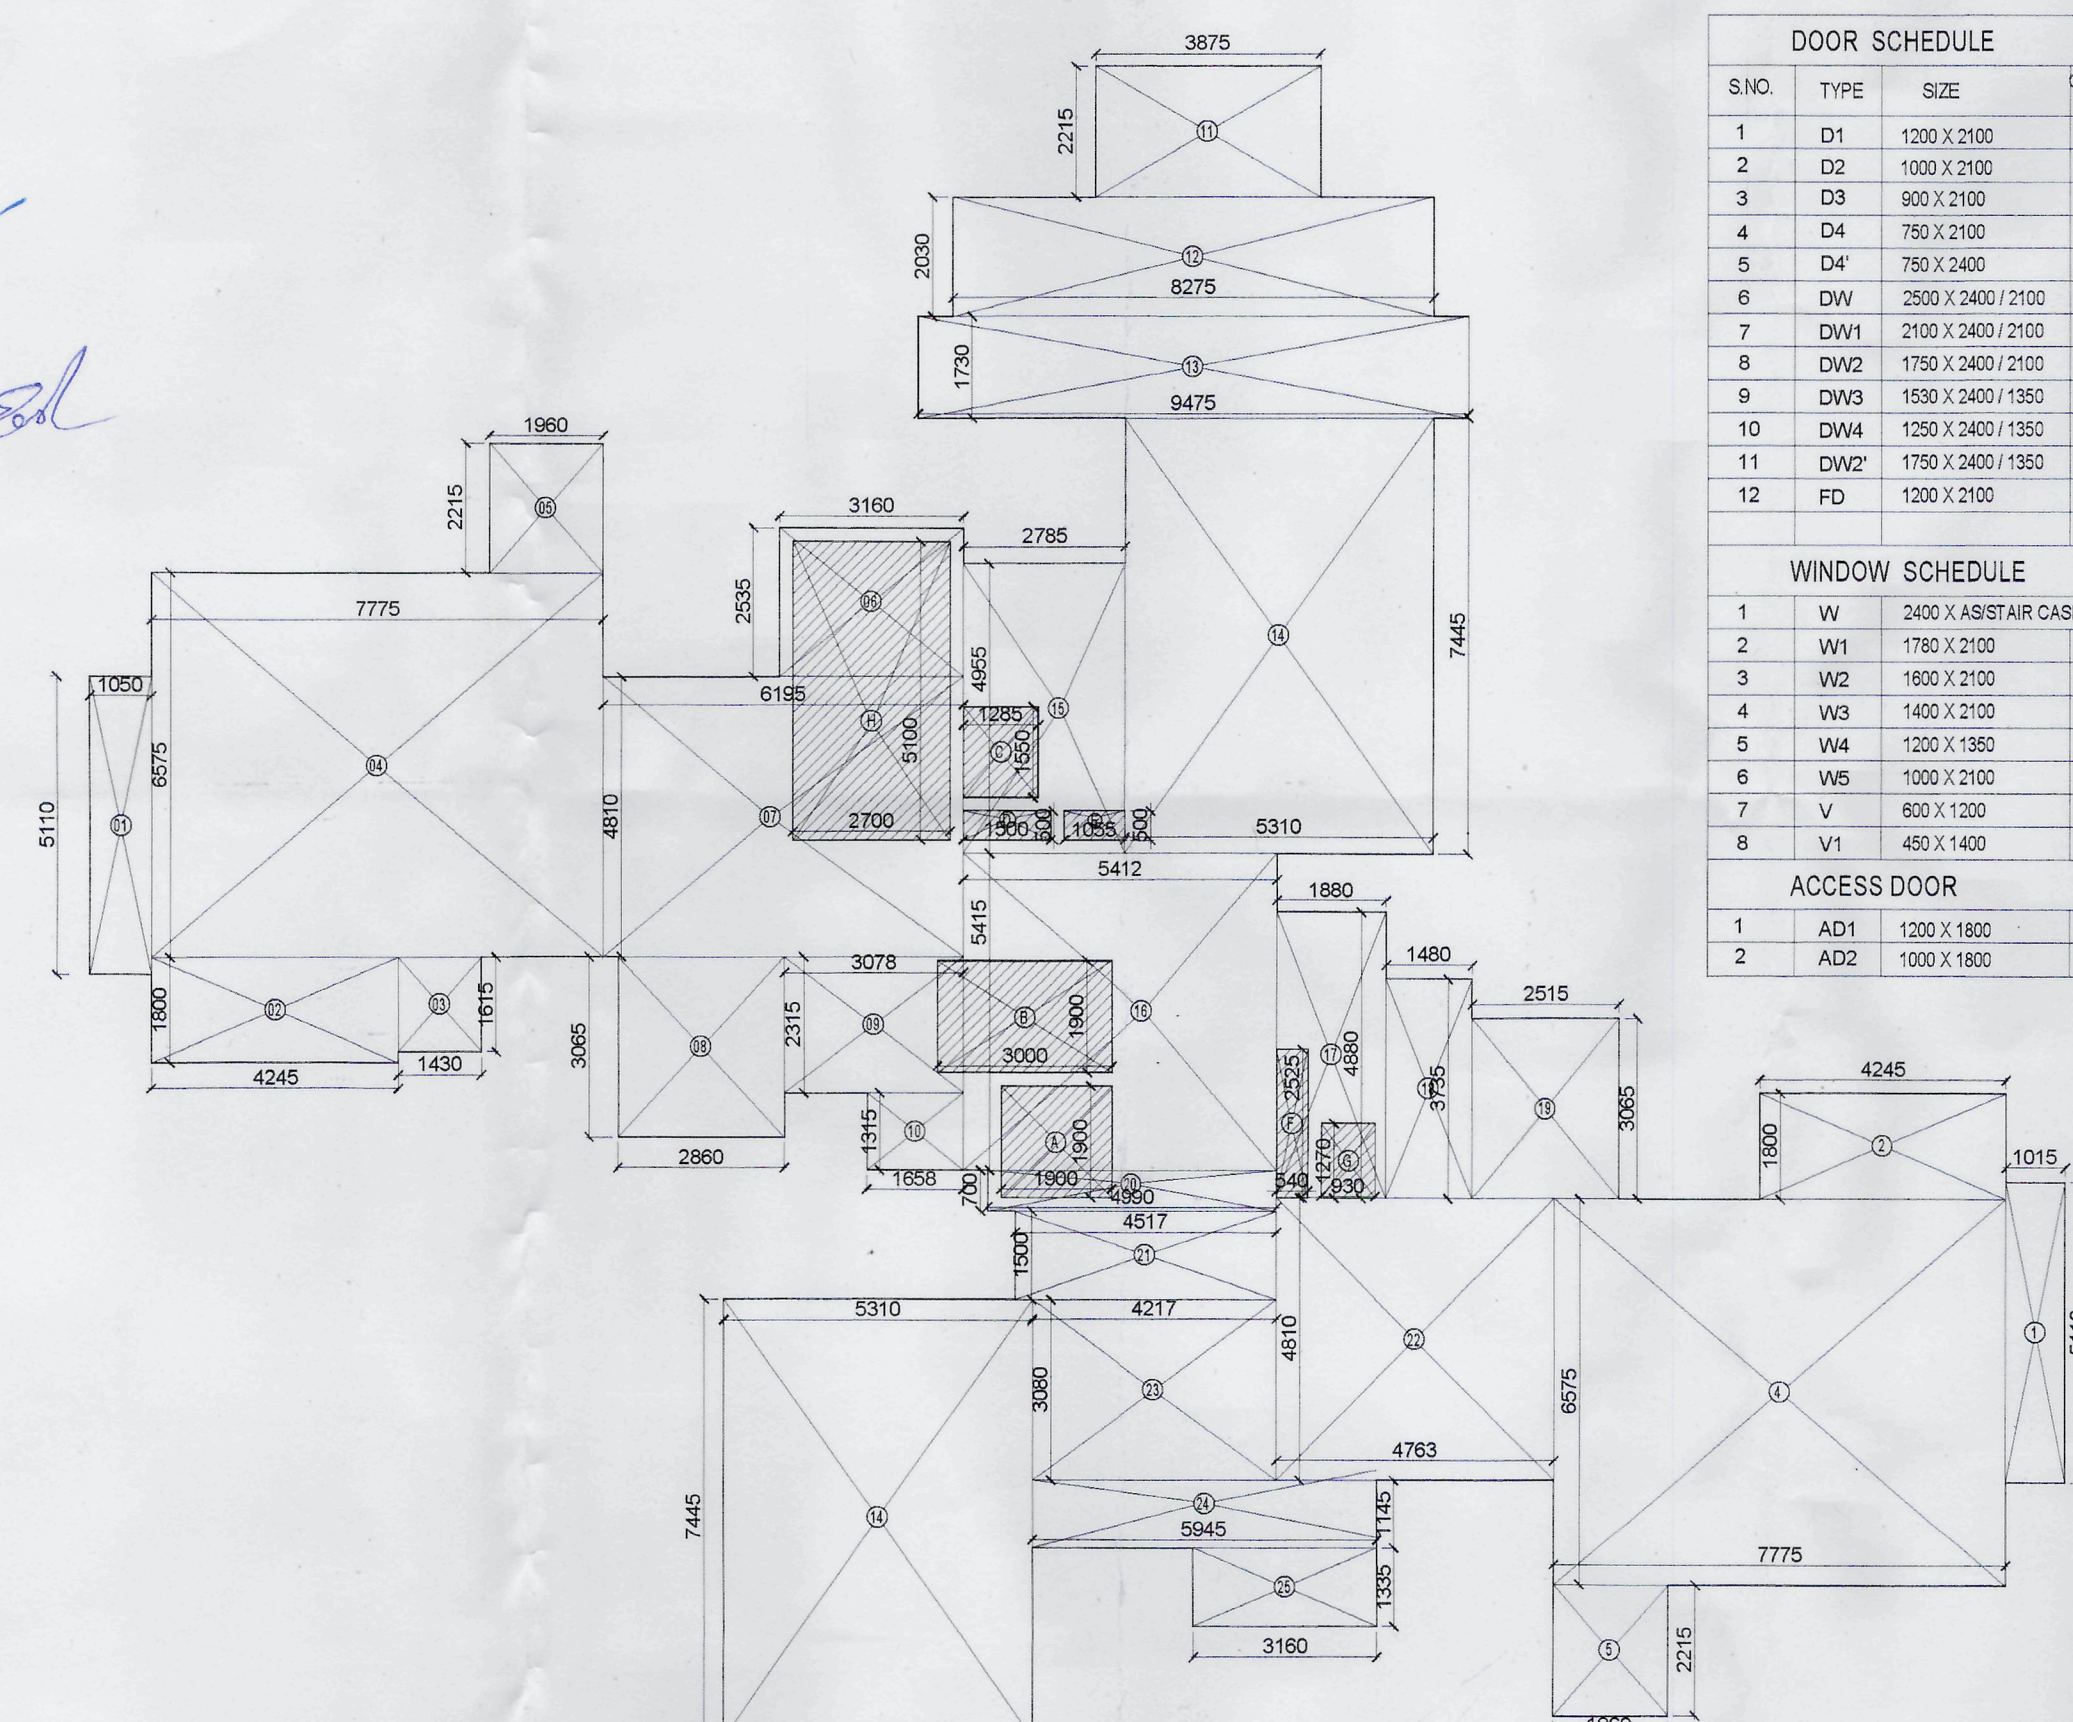

DOOR SCHEDULE				
S/NO	TYPE	SIZE	ILLUMINEL LEVEL	UNTEL LEVEL
1	D1	1200 X 2100	00	2100
2	D2	1000 X 2100	00	2100
3	D3	600 X 2100	00	2100
4	D4	750 X 2100	00	2100
5	D4'	750 X 2400	00	2400
6	DW	2500 X 2400 / 2100	00/300	2400
7	DW1	2100 X 2400 / 2100	00/300	2400
8	DW2	1750 X 2400 / 2100	00/300	2400
9	DW3	1550 X 2400 / 1550	00/1050	2400
10	DW4	1250 X 2400 / 1550	00/1050	2400
11	DW2'	1750 X 2400 / 1550	00/1050	2400
12	FD	1200 X 2100	00	2100

WINDOW SCHEDULE				
S/NO	W	SIZE	3000 X 4500 CASE DETAIL	3000 X 4500 CASE DETAIL
1	W1	1750 X 2100	300	2400
2	W2	1600 X 2100	300	2400
3	W3	1400 X 2100	300	2400
4	W4	1200 X 1950	1050	2400
5	W5	1000 X 2100	300	2400
6	W6	800 X 1200	1200	2400
7	W7	450 X 1400	1000	2400

ACCESS DOOR				
S/NO	AD	SIZE	300	2100
1	AD1	1200 X 1800	300	2100
2	AD2	1000 X 1800	300	2100


TOWER E - TYPICAL FLOOR F.A.R./COVERED AREA CALCULATIONS						
TOTAL AREA						
NO.	LENGTH	WIDTH	AREA	NO.	TOTAL	
01	1.05	5.11	0 5.366	2	10.731	SQMT.
02	1.8	4.245	0 7.641	2	15.282	SQMT.
03	1.43	1.615	0 2.309	1	2.309	SQMT.
04	7.775	6.575	0 51.121	2	102.241	SQMT.
05	2.215	1.96	0 4.341	2	8.683	SQMT.
06	2.535	3.16	0 8.011	1	8.011	SQMT.
07	6.195	4.8	0 29.736	1	29.736	SQMT.
08	3.065	2.86	0 8.766	1	8.766	SQMT.
09	3.078	2.315	0 7.126	1	7.126	SQMT.
10	1.315	1.698	0 2.180	1	2.180	SQMT.
11	3.875	2.215	0 8.583	2	17.166	SQMT.
12	2.09	8.275	0 16.798	2	33.597	SQMT.
13	1.73	9.475	0 16.392	2	32.784	SQMT.
14	7.445	5.31	0 39.533	2	79.066	SQMT.
15	4.955	2.785	0 13.800	1	13.800	SQMT.
16	5.412	5.415	0 29.306	1	29.306	SQMT.
17	1.88	4.88	0 9.174	1	9.174	SQMT.
18	3.735	1.48	0 5.528	1	5.528	SQMT.
19	2.515	3.065	0 7.708	1	7.708	SQMT.
20	4.99	0.7	0 3.493	1	3.493	SQMT.
21	4.517	1.5	0 6.776	1	6.776	SQMT.
22	4.763	4.81	0 22.910	1	22.910	SQMT.
23	4.217	3.08	0 12.988	1	12.988	SQMT.
24	5.945	1.145	0 6.807	1	6.807	SQMT.
25	3.16	1.335	0 4.219	1	4.219	SQMT.
TOTAL (A)					480.386	SQMT.

LIFT WELL					
NO.	LENGTH	WIDTH	AREA	NO.	TOTAL
A	1.9	1.9	0 3.610	1	3.610
B	1.9	3	0 5.700	1	5.700
TOTAL (B)					9.310

FIRE STAIRCASE (free of far)					
NO.	LENGTH	WIDTH	AREA	NO.	TOTAL
H	2.7	5.1	0 13.770	1	13.770
TOTAL (C)					13.770

CUT-OUT					
NO.	LENGTH	WIDTH	AREA	NO.	TOTAL
C	1.55	1.285	0 1.992	1	1.992
D	0.5	1.5	0 0.750	1	0.750
E	0.5	1.055	0 0.528	1	0.528
F	2.525	0.54	0 1.364	1	1.364
G	1.27	0.93	0 1.181	1	1.181
TOTAL (D)					5.814

TOTAL FAR AREA = A-(B+C+D) = 451.492 SQMT.

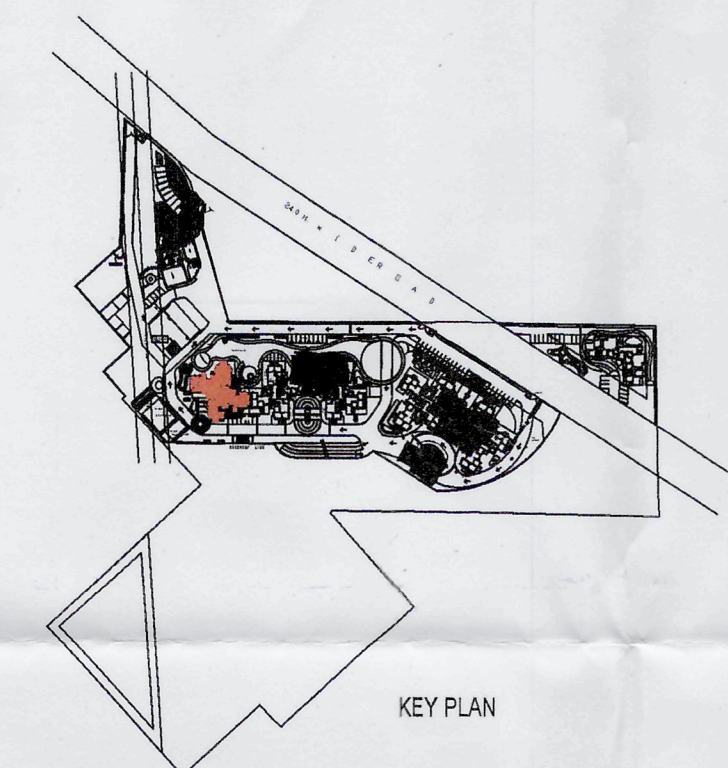

PROJECT:- PROPOSED PROPOSED GROUP HOUSING AT PLOT NO.- THE ESPHERA' AT SECTOR-37 C, GURGAON FOR -----	ARCHITECT'S SIGNATURE RAJIV ZANDHI ARCHITECT LIC. NO. CA/91/13852	CLIENT'S SIGNATURE For Imperia Structures Limited Authorised Signatory	LOCAL AUTHORITY SUBMISSION SCALE : 1:100 DATE : ----	SUBMISSION DRAWING TOWER (E) TYPICAL FLOOR	DRG. NO. DFA/SUB/TOW./115 REV. N
---	--	--	--	--	---

dfA
DESIGN FORUM
OF ARCHITECTS
www.dfa.in
C-10, SECTOR-3, NOIDA - 201301
(NCR DELHI) INDIA
TEL: +91 120 460 1000
FAX: +91 120 460 1000
dfacultans@gmail.com