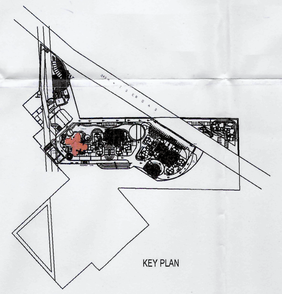

DTP
ATP
AD
FI. Eol

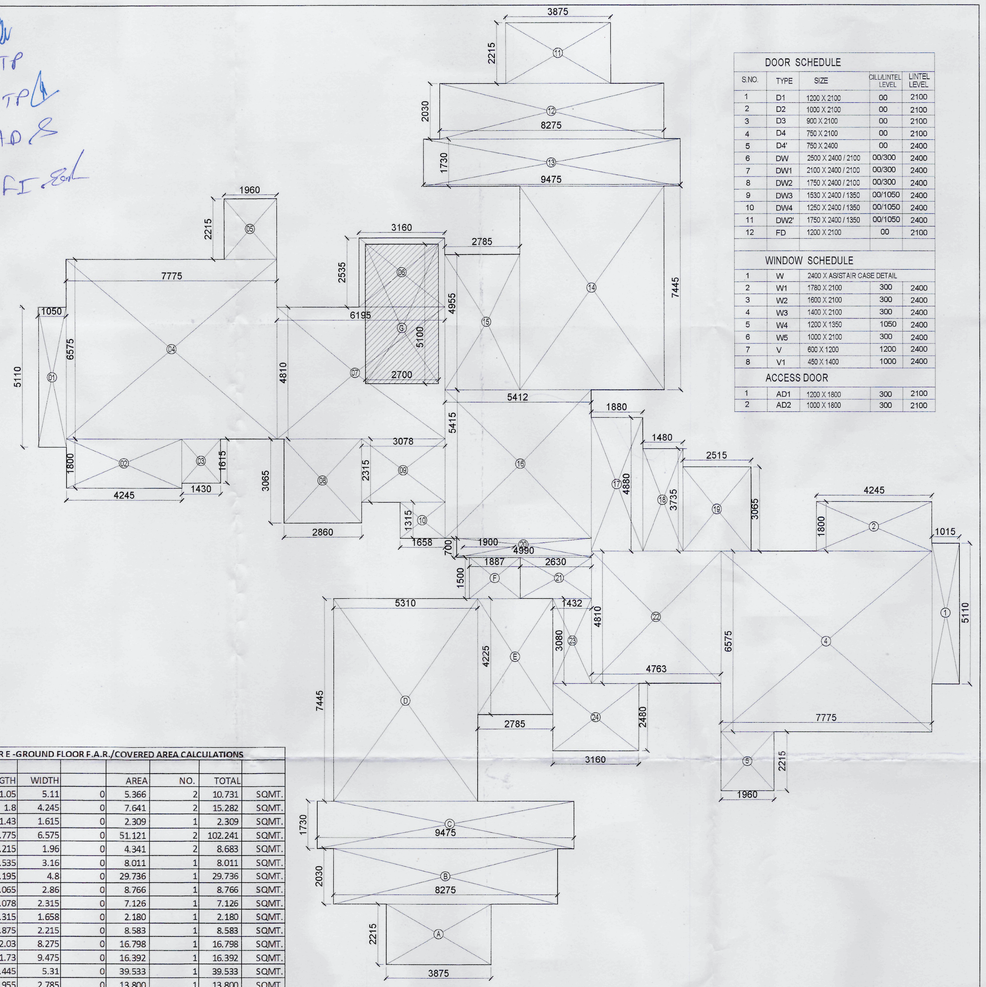

DOOR SCHEDULE				
S.NO.	TYPE	SIZE	CILL/LINTEL LEVEL	LINTEL LEVEL
1	D1	1200 X 2100	00	2100
2	D2	1000 X 2100	00	2100
3	D3	900 X 2100	00	2100
4	D4	750 X 2100	00	2100
5	D4'	750 X 2400	00	2400
6	DW	2500 X 2400 / 2100	00/300	2400
7	DW1	2100 X 2400 / 2100	00/300	2400
8	DW2	1750 X 2400 / 2100	00/300	2400
9	DW3	1530 X 2400 / 1350	00/1050	2400
10	DW4	1250 X 2400 / 1350	00/1050	2400
11	DW2'	1750 X 2400 / 1350	00/1050	2400
12	FD	1200 X 2100	00	2100

WINDOW SCHEDULE				
1	W	2400 X ASIST.AIR CASE DETAIL		
2	W1	1780 X 2100	300	2400
3	W2	1600 X 2100	300	2400
4	W3	1400 X 2100	300	2400
5	W4	1200 X 1350	1050	2400
6	W5	1000 X 2100	300	2400
7	V	600 X 1200	1200	2400
8	V1	450 X 1400	1000	2400

ACCESS DOOR				
1	AD1	1200 X 1800	300	2100
2	AD2	1000 X 1800	300	2100

TOWER E -GROUND FLOOR F.A.R./COVERED AREA CALCULATIONS

TOTAL AREA

	LENGTH	WIDTH		AREA	NO.	TOTAL	
01	1.05	5.11	0	5.366	2	10.731	SQMT.
02	1.8	4.245	0	7.641	2	15.282	SQMT.
03	1.43	1.615	0	2.309	1	2.309	SQMT.
04	7.775	6.575	0	51.121	2	102.241	SQMT.
05	2.215	1.96	0	4.341	2	8.683	SQMT.
06	2.535	3.16	0	8.011	1	8.011	SQMT.
07	6.195	4.8	0	29.736	1	29.736	SQMT.
08	3.065	2.86	0	8.766	1	8.766	SQMT.
09	3.078	2.315	0	7.126	1	7.126	SQMT.
10	1.315	1.658	0	2.180	1	2.180	SQMT.
11	3.875	2.215	0	8.583	1	8.583	SQMT.
12	2.03	8.275	0	16.798	1	16.798	SQMT.
13	1.73	9.475	0	16.392	1	16.392	SQMT.
14	7.445	5.31	0	39.533	1	39.533	SQMT.
15	4.955	2.785	0	13.800	1	13.800	SQMT.
16	5.412	5.415	0	29.306	1	29.306	SQMT.
17	1.88	4.88	0	9.174	1	9.174	SQMT.
18	3.735	1.48	0	5.528	1	5.528	SQMT.
19	2.515	3.065	0	7.708	1	7.708	SQMT.
20	4.99	0.7	0	3.493	1	3.493	SQMT.
21	2.63	1.5	0	3.945	1	3.945	SQMT.
22	4.763	4.81	0	22.910	1	22.910	SQMT.
23	1.432	3.08	0	4.411	1	4.411	SQMT.
24	3.16	2.48	0	7.837	1	7.837	SQMT.
					TOTAL (A)	384.483	SQMT.

FIRE STAIRCASE (free of far)

	LENGTH	WIDTH		AREA	NO.	TOTAL	
G	2.7	5.1	0	13.77	1	13.77	SQMT.
					TOTAL (B)	13.770	SQMT.
TOTAL FAR AREA = A-B						370.713	SQMT.

STILT AREA

A	3.875	2.215	0	8.583	1	8.583	SQMT.
B	2.03	8.275	0	16.798	1	16.798	SQMT.
C	1.73	9.475	0	16.392	1	16.392	SQMT.
D	7.445	5.31	0	39.533	1	39.533	SQMT.
E	2.785	4.225	0	11.767	1	11.767	SQMT.
F	1.5	1.887	0	2.831	1	2.831	SQMT.
					TOTAL (A)	95.903	SQMT.
TOTAL STILT AREA						95.903	SQMT.

TOWER E

S.NO.	ATTRIBUTES	SANCTIONED F.A.R.(SQMT.)	ACHIEVED F.A.R.(SQMT)	ADDED AREA WITHOUT SANCTION
1	GROUND FLOOR	373.78	370.713	-3.067
2	1ST.FLOOR	451.956	451.492	0.000
3	2ND. FLOOR	451.956	451.492	0.000
4	3RD. FLOOR	451.956	451.492	0.000
5	4TH. FLOOR	451.956	451.492	0.000
6	5TH. FLOOR	451.956	451.492	0.000
7	6TH. FLOOR	451.956	451.492	0.000
8	7TH. FLOOR	451.956	451.492	0.000
9	8TH. FLOOR	451.956	451.492	0.000
10	9TH. FLOOR	451.956	451.492	0.000
11	10TH. FLOOR	451.956	451.492	0.000
12	11TH. FLOOR	451.956	451.492	0.000
13	12TH. FLOOR	451.956	451.492	0.000
14	13TH. FLOOR	451.956	451.492	0.000
15	14TH. FLOOR	451.956	451.492	0.000
16	15TH. FLOOR	451.956	451.492	0.000
17	16TH. FLOOR	451.956	451.492	0.000
18	17TH. FLOOR	451.956	451.492	0.000
19	18TH.FLOOR	451.956	451.492	0.000
20	19TH.FLOOR	451.956	451.492	0.000
21	TERRACE			
	TOTAL	**8960.944**	**8949.060**	**-3.067**

PROJECT:-
PROPOSED
PROPOSED GROUP HOUSING AT PLOT NO.-
THE ESPHERA' AT SECTOR-37 C, GURGAON
FOR ----------

ARCHITECT'S SIGNATURE
RAJIV GANDHI
ARCHITECT
LIC. No. CA / 91/ 13852

CLIENT'S SIGNATURE
For Imperia Structures Limited
Authorised Signatory

LOCAL AUTHORITY SUBMISSION
SCALE : 1:100
DATE : ----

SUBMISSION DRAWING
TOWER (E)
GROUND FLOOR

dfA
DESIGN FORUM OF ARCHITECTS
www.dfa.in
C-10, SECTOR-3, NOIDA-201301
(NCR DELHI) INDIA
TEL: +91 120 460 1000
FAX: +91 120 460 1000
dfaconsultants@gmail.com

DRG. NO.
DFA/SUB/TOW./115
REV.
N